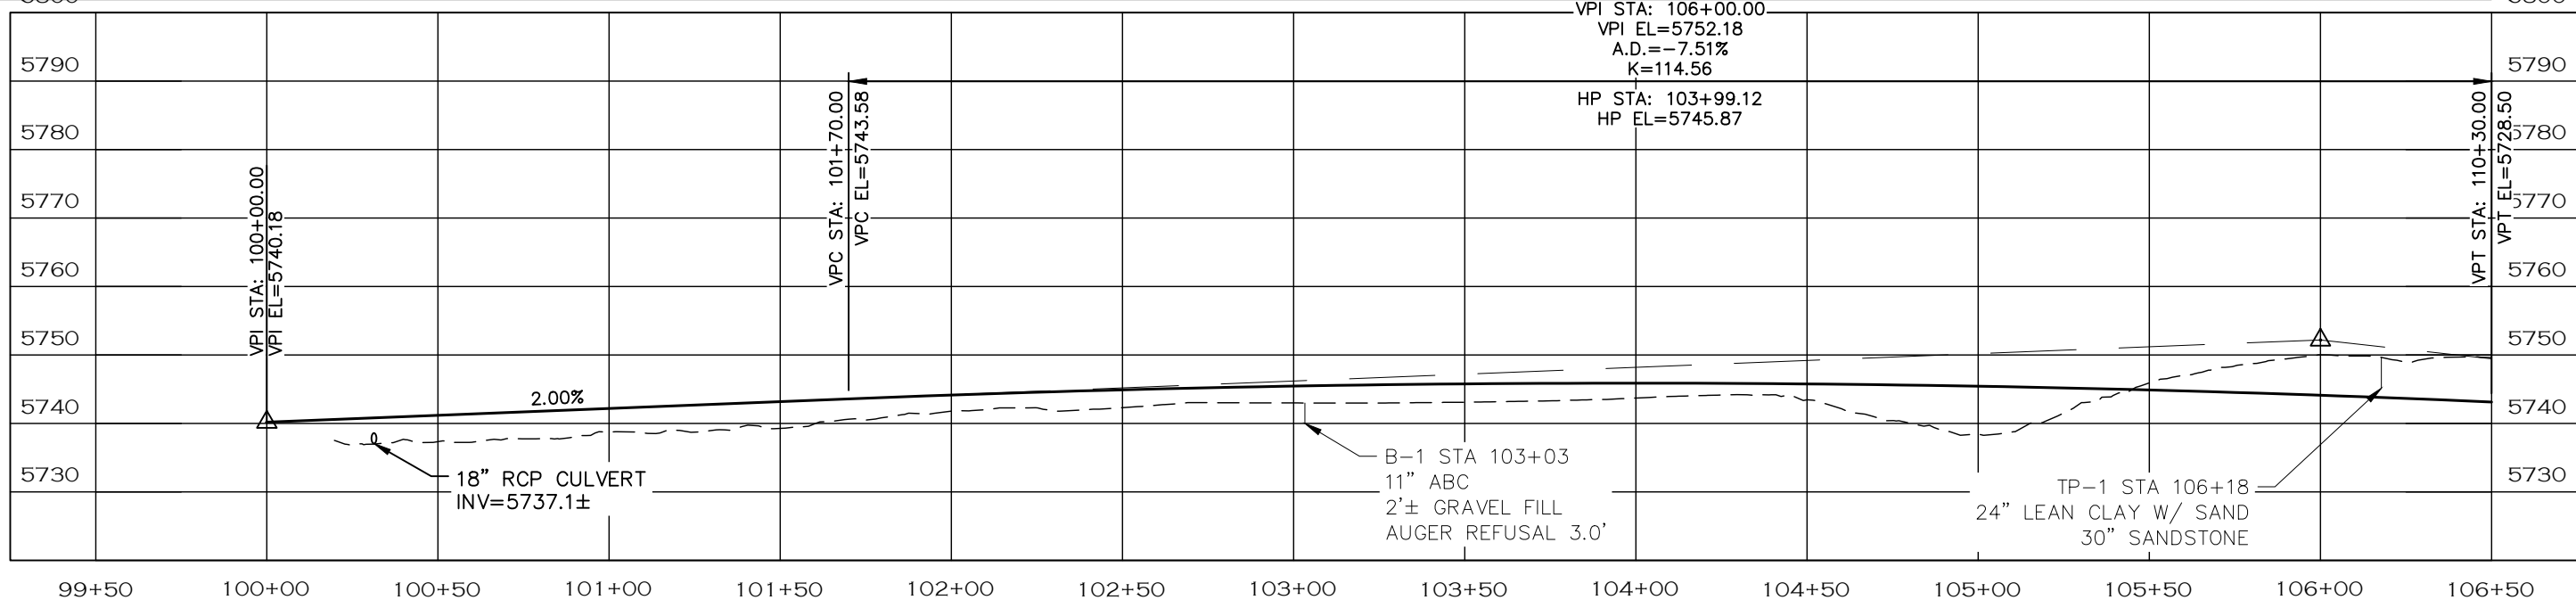
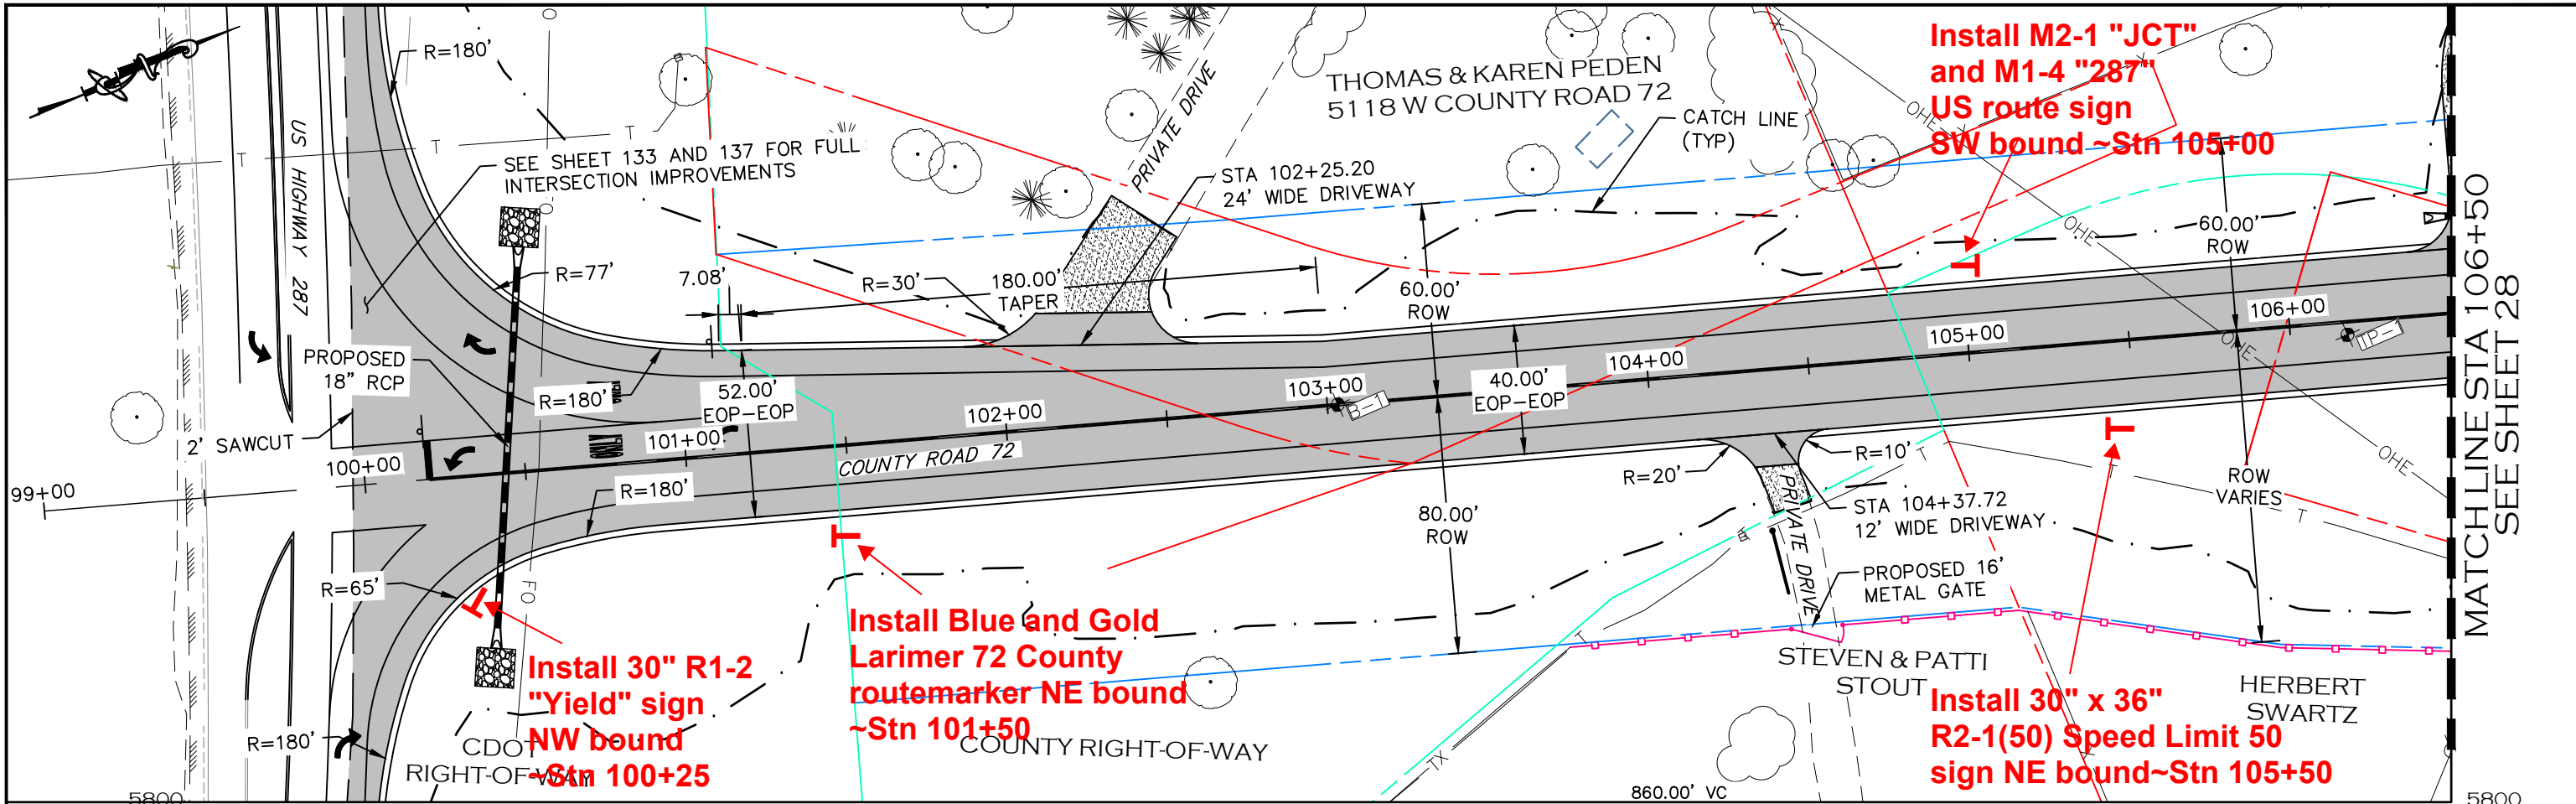





NOTE

1. ALL DRIVEWAY RADII ARE 15 FEET UNLESS OTHERWISE NOTED.
2. PROPOSED FENCE TO BE SET ON PROPOSED ROW. FENCES SHOWN 1' OFF PROPOSED ROW FOR GRAPHICAL PURPOSES.
3. STA 105+45 TO STA 108+00: EXCAVATIONS PENETRATING THE CEMENTED SANDSTONE BEDROCK FORMATION AT INCREASED DEPTHS MAY REQUIRE THE USE OF SPECIALIZED HEAVY-DUTY EQUIPMENT TO FACILITATE ROCK BREAK-UP AND REMOVAL.

- PROPOSED FENCE
- TEMPORARY CONSTRUCTION EASEMENT
- PROPOSED RIGHT-OF-WAY
- EXISTING RIGHT-OF-WAY
- EXISTING PROPERTY LINE

CALL UTILITY NOTIFICATION
CENTER OF COLORADO
811
CALL 2-BUSINESS DAYS IN ADVANCE
BEFORE YOU DIG, GRADE, OR EXCAVATE
FOR THE MARKING OF UNDERGROUND
MEMBER UTILITIES.

COMPUTER INFORMATION		REVISIONS			ENGINEERING DEPARTMENT 200 WEST OAK, SUITE 3000 POST OFFICE BOX 1190 FORT COLLINS, COLORADO 80522-1190 (970)498-5700 (970)498-7986 FAX	AS CONSTRUCTED		PLAN & PROFILE STATION 100+00 TO 106+50	PROJECT NO. 335	
CREATION DATE:	07/13/20	☐ R-1				NO REVISIONS:			LARIMER COUNTY ROAD 72	
MODIFICATION DATE:	02/01/21	☐ R-2				REVISED:			SHEET NO. 27	
FILE LOCATION:	INTEREST PROJECTS\2019 PROJECTS\1421-094-00 (LARIMER COUNTY ROAD 72)\DRAWINGS\ENGINEERING PLANS	☐ R-3				VOID:				
FILE NAME:	1421-094-00 P&P.DWG	☐ R-4								
		☐ R-5								

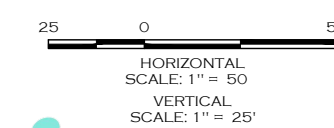
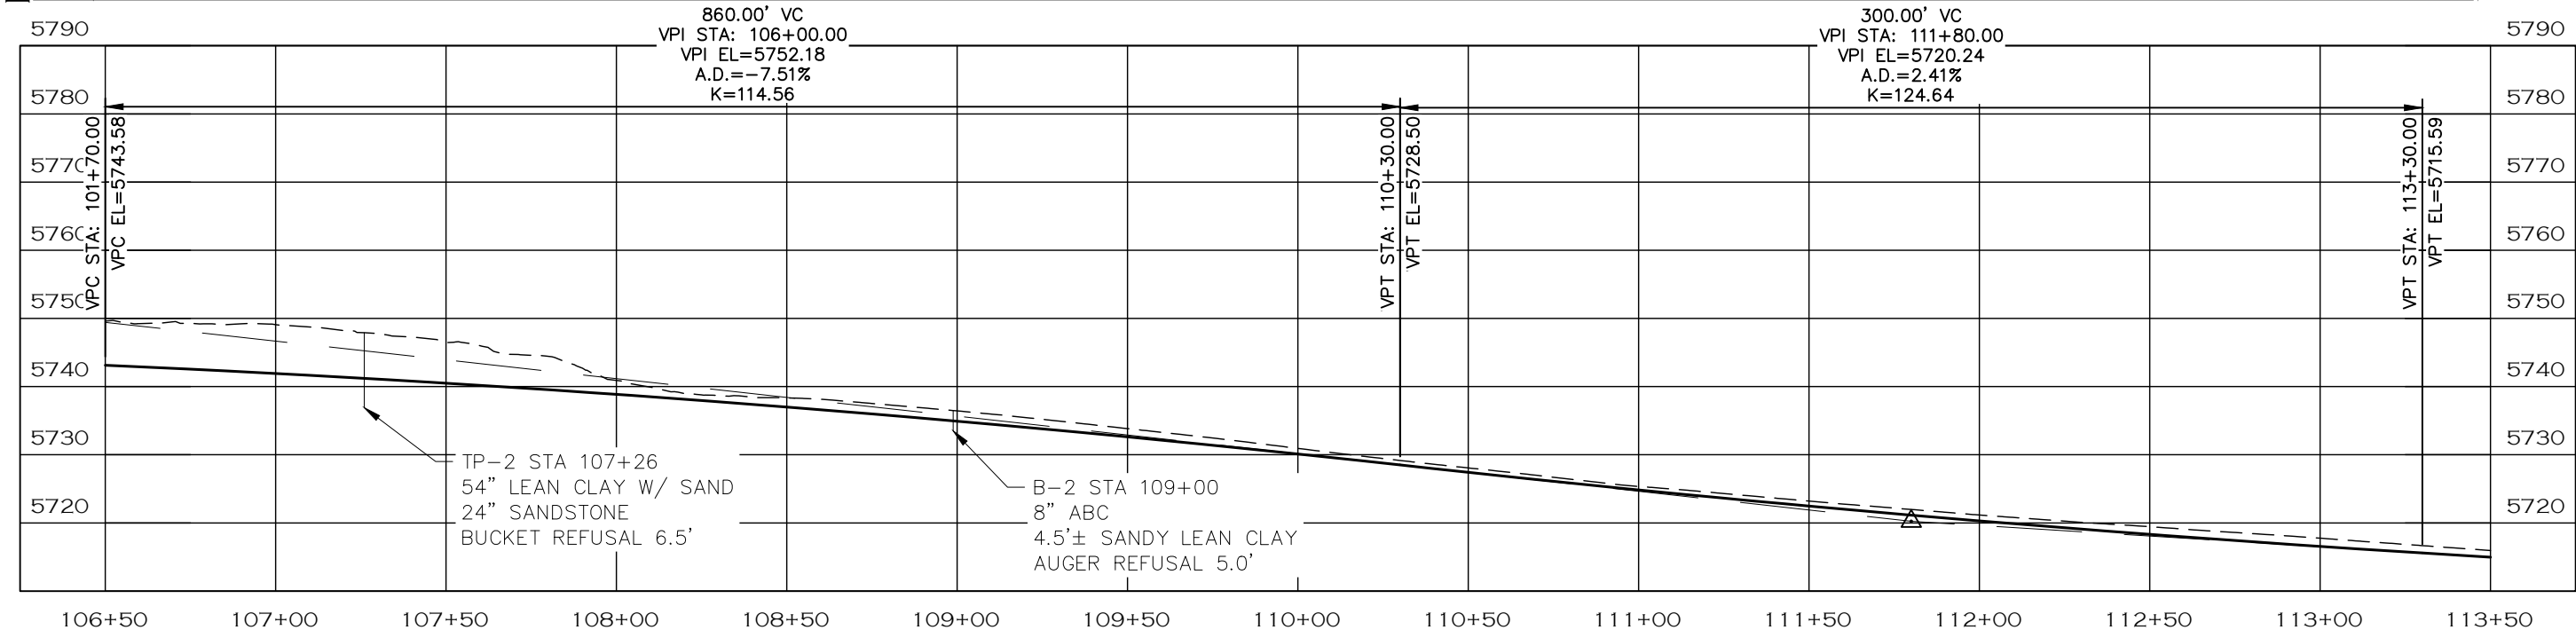
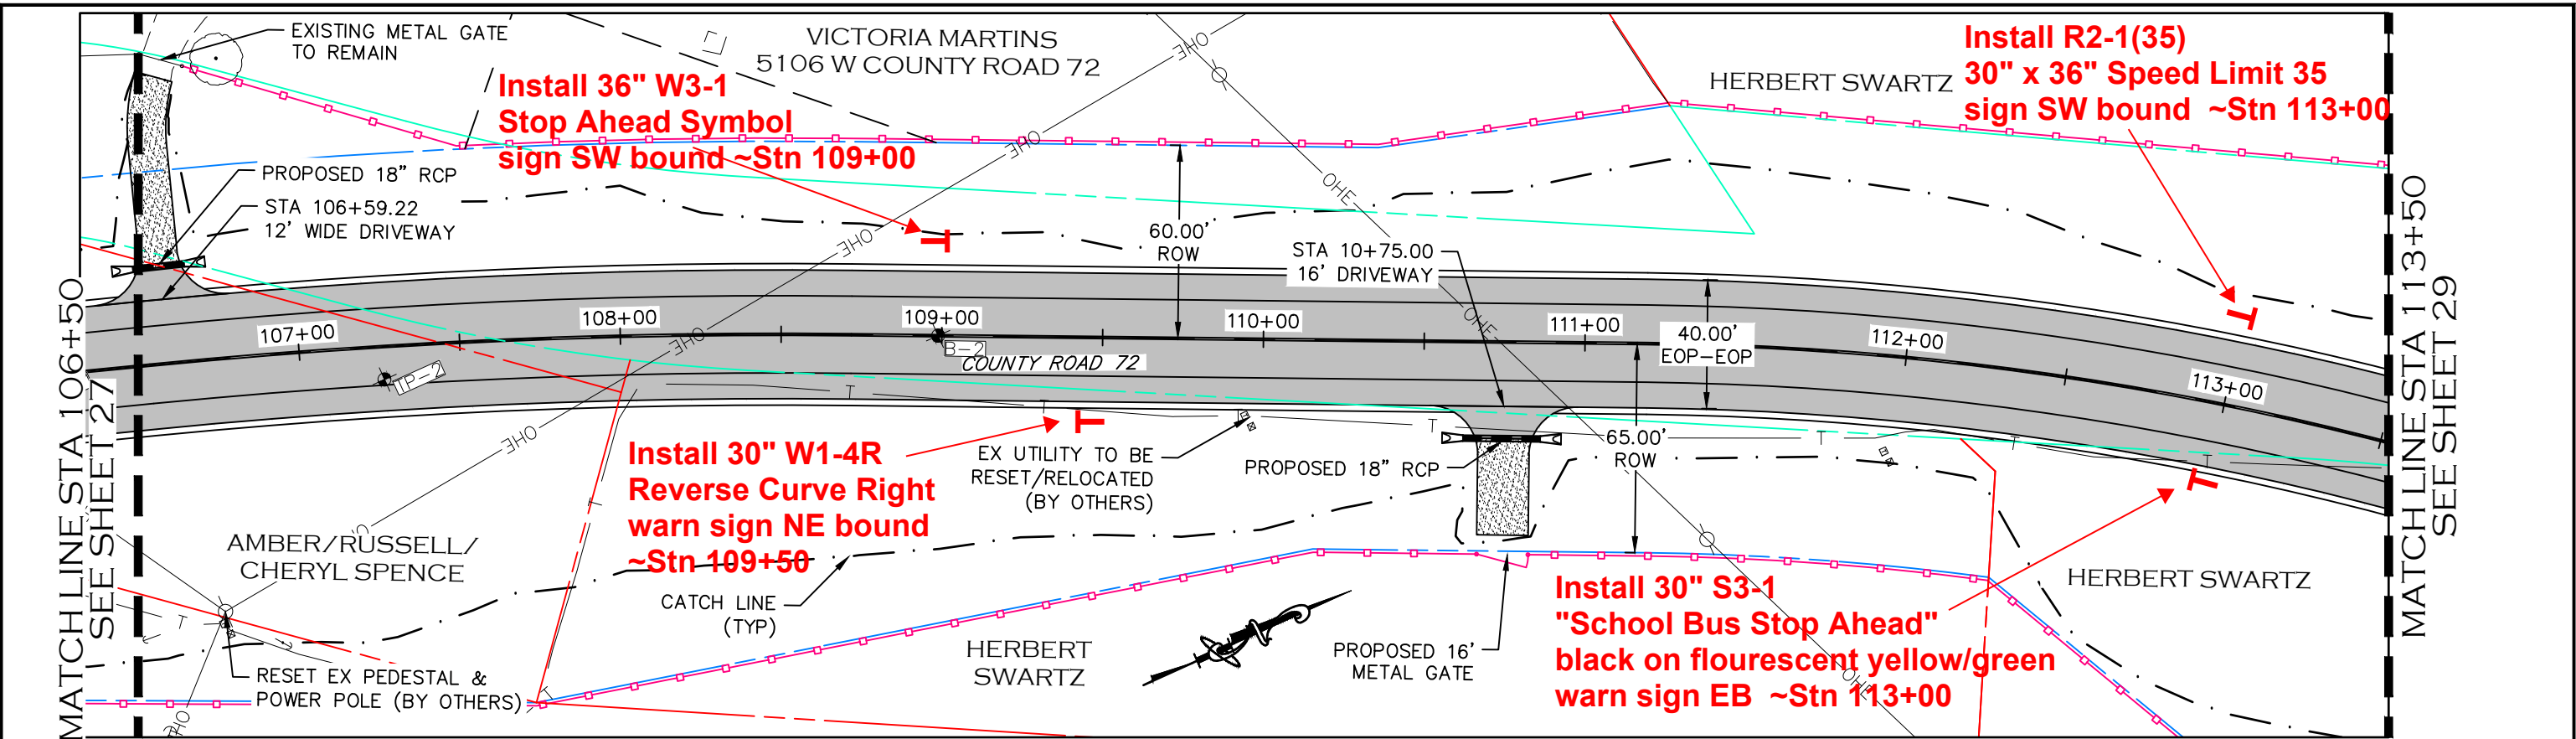


- NOTE**
1. ALL DRIVEWAY RADII ARE 15 FEET UNLESS OTHERWISE NOTED.
 2. PROPOSED FENCE TO BE SET ON PROPOSED ROW. FENCES SHOWN 1' OFF PROPOSED ROW FOR GRAPHICAL PURPOSES.
 3. STA 105+45 TO STA 108+00: EXCAVATIONS PENETRATING THE CEMENTED SANDSTONE BEDROCK FORMATION AT INCREASED DEPTHS MAY REQUIRE THE USE OF SPECIALIZED HEAVY-DUTY EQUIPMENT TO FACILITATE ROCK BREAK-UP AND REMOVAL.

- PROPOSED FENCE
- TEMPORARY CONSTRUCTION EASEMENT
- PROPOSED RIGHT-OF-WAY
- EXISTING RIGHT-OF-WAY
- EXISTING PROPERTY LINE

CALL UTILITY NOTIFICATION
CENTER OF COLORADO
811
CALL 2-BUSINESS DAYS IN ADVANCE
BEFORE YOU DIG, GRADE, OR EXCAVATE
FOR THE MARKING OF UNDERGROUND
MEMBER UTILITIES.

COMPUTER INFORMATION		REVISIONS			ENGINEERING DEPARTMENT 200 WEST OAK, SUITE 3000 POST OFFICE BOX 1190 FORT COLLINS, COLORADO 80522-1190 (970)498-5700 (970)498-7986 FAX	AS CONSTRUCTED		PLAN & PROFILE STATION 106+50 TO 113+50	PROJECT NO. 335	
CREATION DATE:	07/13/20	☐ R-1				NO REVISIONS:			LARIMER COUNTY ROAD 72	
MODIFICATION DATE:	02/01/21	☐ R-2				REVISED:			SHEET NO. 28	
FILE LOCATION:	INTEREST PROJECTS\2019 PROJECTS\1421-094-00 (LARIMER COUNTY ROAD 72)\DRAWINGS\ENGINEERING PLANS	☐ R-3				VOID:				
FILE NAME:	1421-094-00 P&P.DWG	☐ R-4								
		☐ R-5								

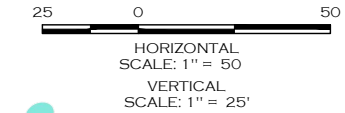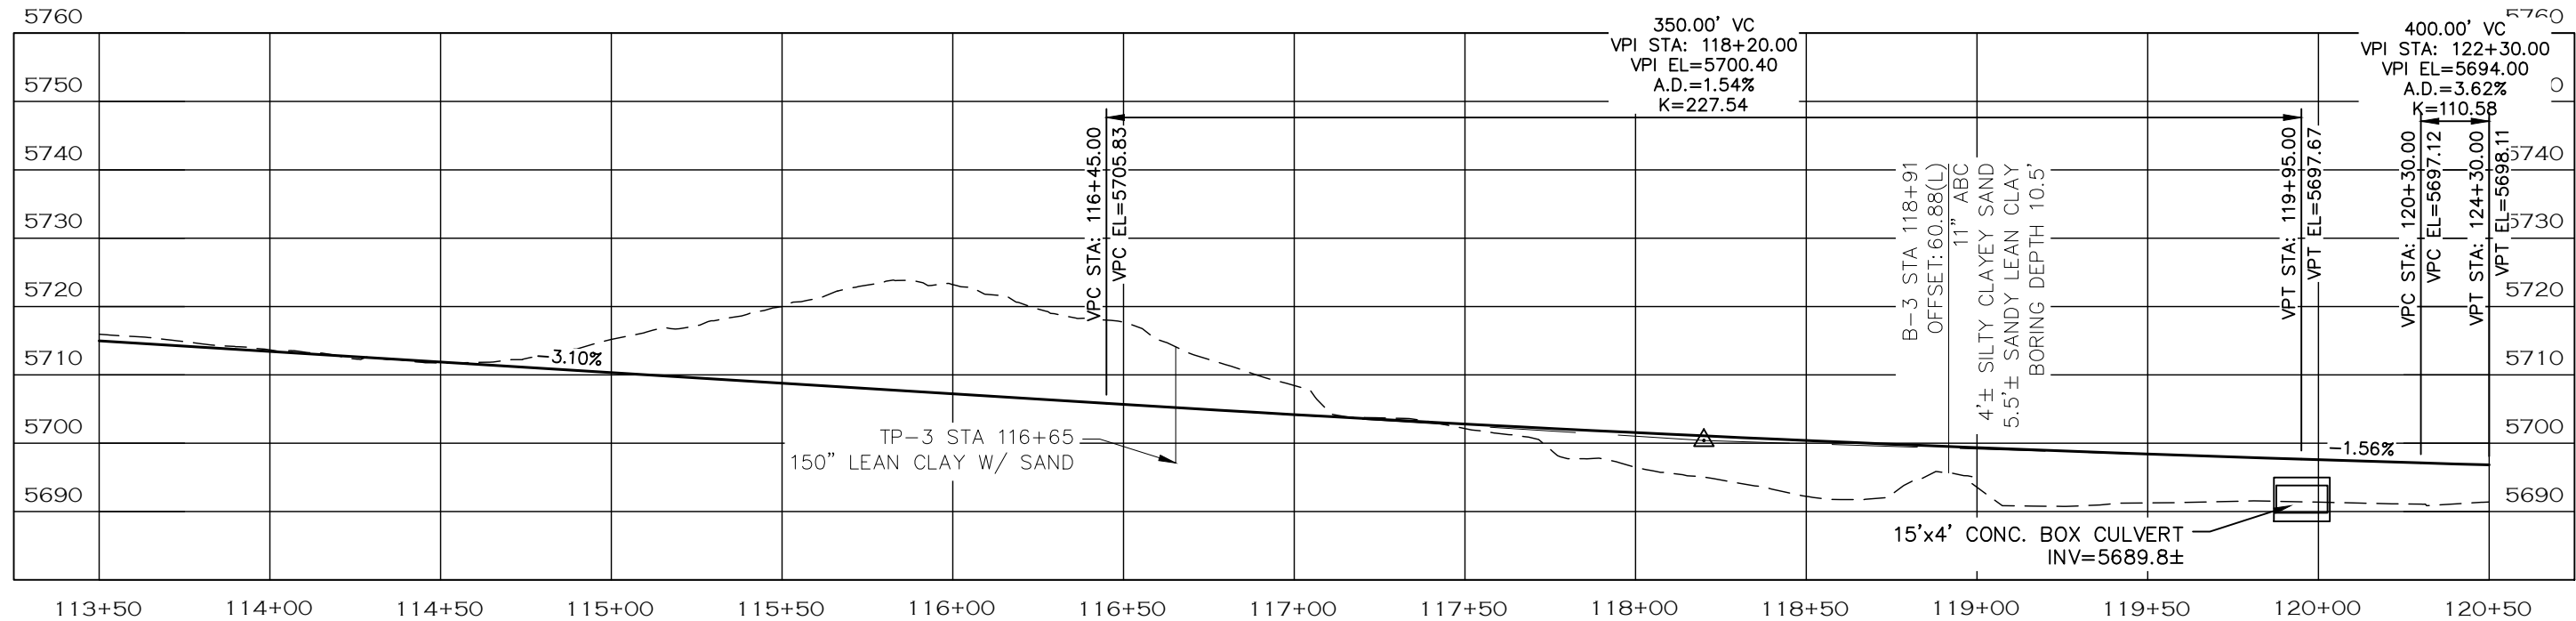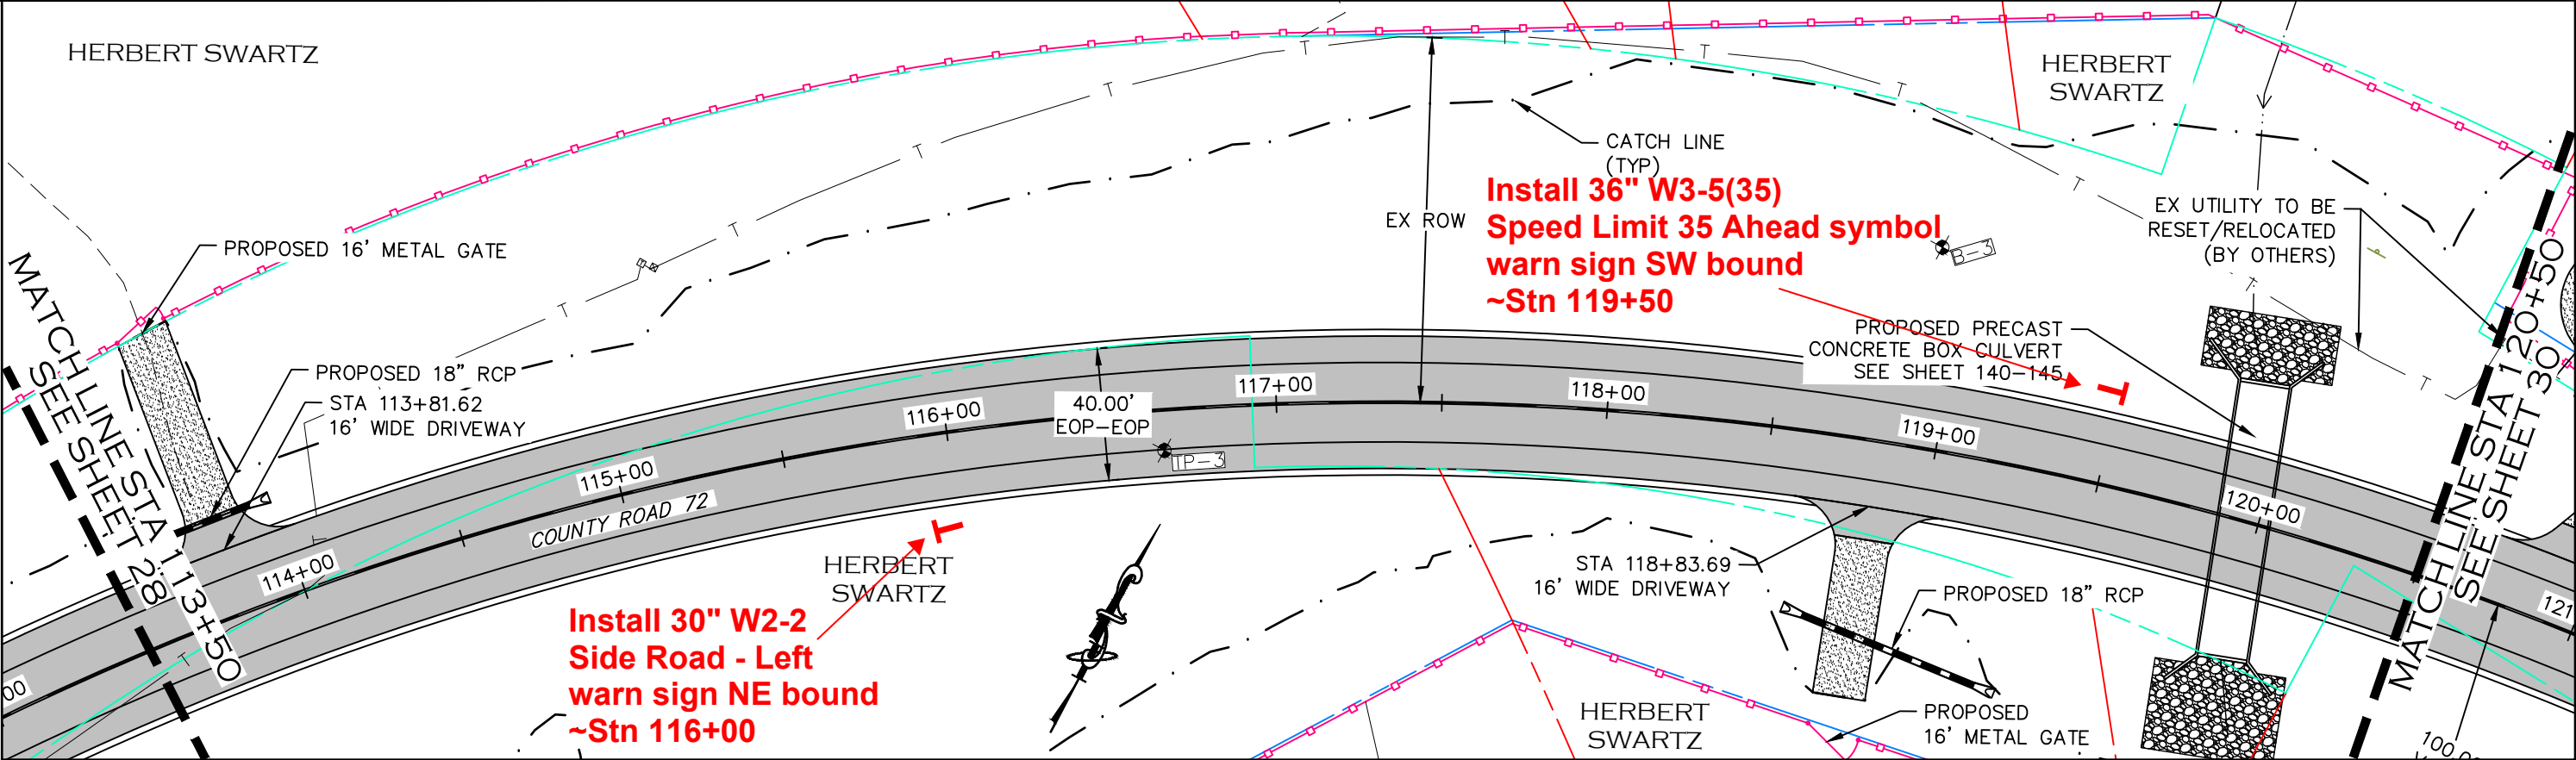


NOTE

1. ALL DRIVEWAY RADII ARE 15 FEET UNLESS OTHERWISE NOTED.
2. PROPOSED FENCE TO BE SET ON PROPOSED ROW. FENCES SHOWN 1' OFF PROPOSED ROW FOR GRAPHICAL PURPOSES.

- PROPOSED FENCE
- TEMPORARY CONSTRUCTION EASEMENT
- PROPOSED RIGHT-OF-WAY
- EXISTING RIGHT-OF-WAY
- EXISTING PROPERTY LINE

CALL UTILITY NOTIFICATION
CENTER OF COLORADO
811
CALL 2-BUSINESS DAYS IN ADVANCE
BEFORE YOU DIG, GRADE, OR EXCAVATE
FOR THE MARKING OF UNDERGROUND
MEMBER UTILITIES.

COMPUTER INFORMATION		REVISIONS			ENGINEERING DEPARTMENT 200 WEST OAK, SUITE 3000 POST OFFICE BOX 1190 FORT COLLINS, COLORADO 80522-1190 (970)498-5700 (970)498-7986 FAX	AS CONSTRUCTED		PLAN & PROFILE STATION 113+50 TO 120+50	PROJECT NO. 335	
CREATION DATE:	07/13/20	R-1				NO REVISIONS:			LARIMER COUNTY ROAD 72	
MODIFICATION DATE:	02/01/21	R-2				REVISED:			SHEET NO. 29	
FILE LOCATION:	INTEREST PROJECTS\2019 PROJECTS\1421-094-00 LARIMER COUNTY ROAD 72\DRAWINGS\ENGINEERING PLANS	R-3				VOID:				
FILE NAME:	1421-094-00 P&P.DWG	R-4								
		R-5								

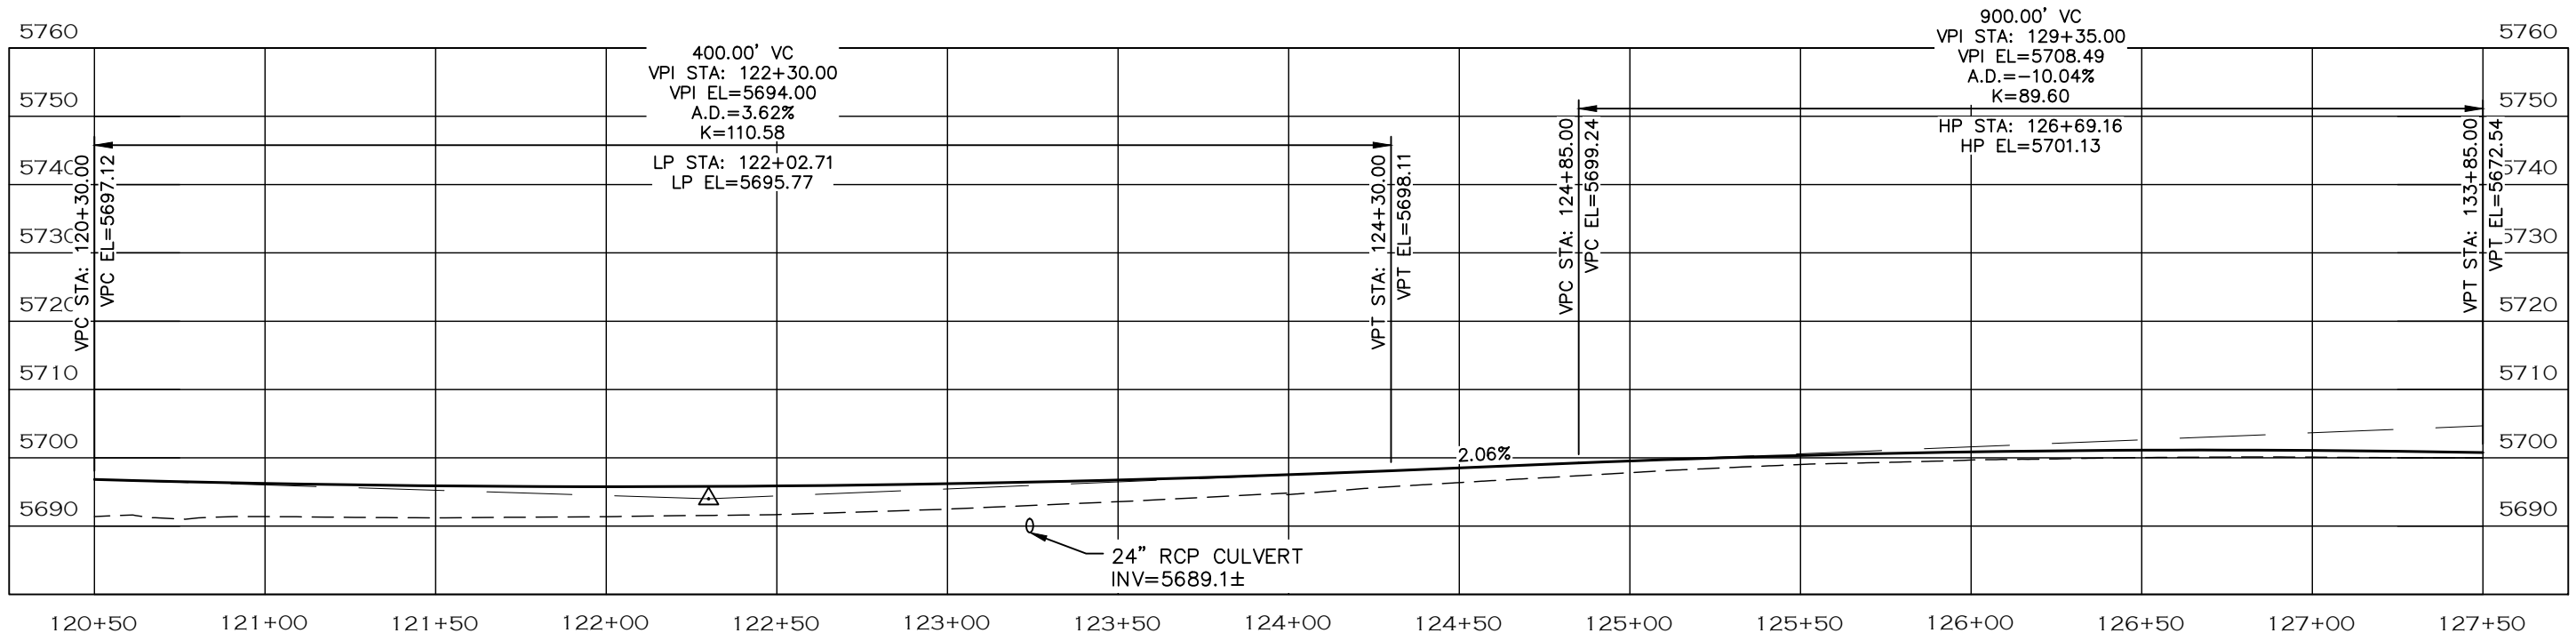


1. ALL DRIVEWAY RADII ARE 15 FEET UNLESS OTHERWISE NOTED.
2. PROPOSED FENCE TO BE SET ON PROPOSED ROW. FENCES SHOWN 1' OFF PROPOSED ROW FOR GRAPHICAL PURPOSES.

-
-  PROPOSED FENCE
 TEMPORARY CONSTRUCTION EASEMENT
 PROPOSED RIGHT-OF-WAY
 EXISTING RIGHT-OF-WAY
 EXISTING PROPERTY LINE


**CALL UTILITY NOTIFICATION
CENTER OF COLORADO
811
CALL 2-BUSINESS DAYS IN ADVANCE
BEFORE YOU DIG, GRADE, OR EXCAVATE
FOR THE MARKING OF UNDERGROUND
MEMBER UTILITIES.**

COMPUTER INFORMATION		REVISIONS		 LARIMER COUNTY ENGINEERING DEPARTMENT 200 WEST OAK, SUITE 3000 POST OFFICE BOX 1190 FORT COLLINS, COLORADO 80522-1190 (970)498-5700 (970)498-7986 FAX	AS CONSTRUCTED		PROJECT NO. 335	
CREATION DATE:	07/13/20	☒ R-1			NO REVISIONS:		LARIMER COUNTY ROAD 72	
MODIFICATION DATE:	02/01/21	☐ R-2			REVISED:			
FILE LOCATION:	INTEREST PROJECTS\2019 PROJECTS\1421-094-00 (LARIMER COUNTY ROAD 72)\DRAWINGS\ENGINEERING PLANS	☐ R-3			VOID:			
FILE NAME:	1421-094-00 P&P.DWG	☐ R-4						
		☐ R-5				SHEET NO. 30		

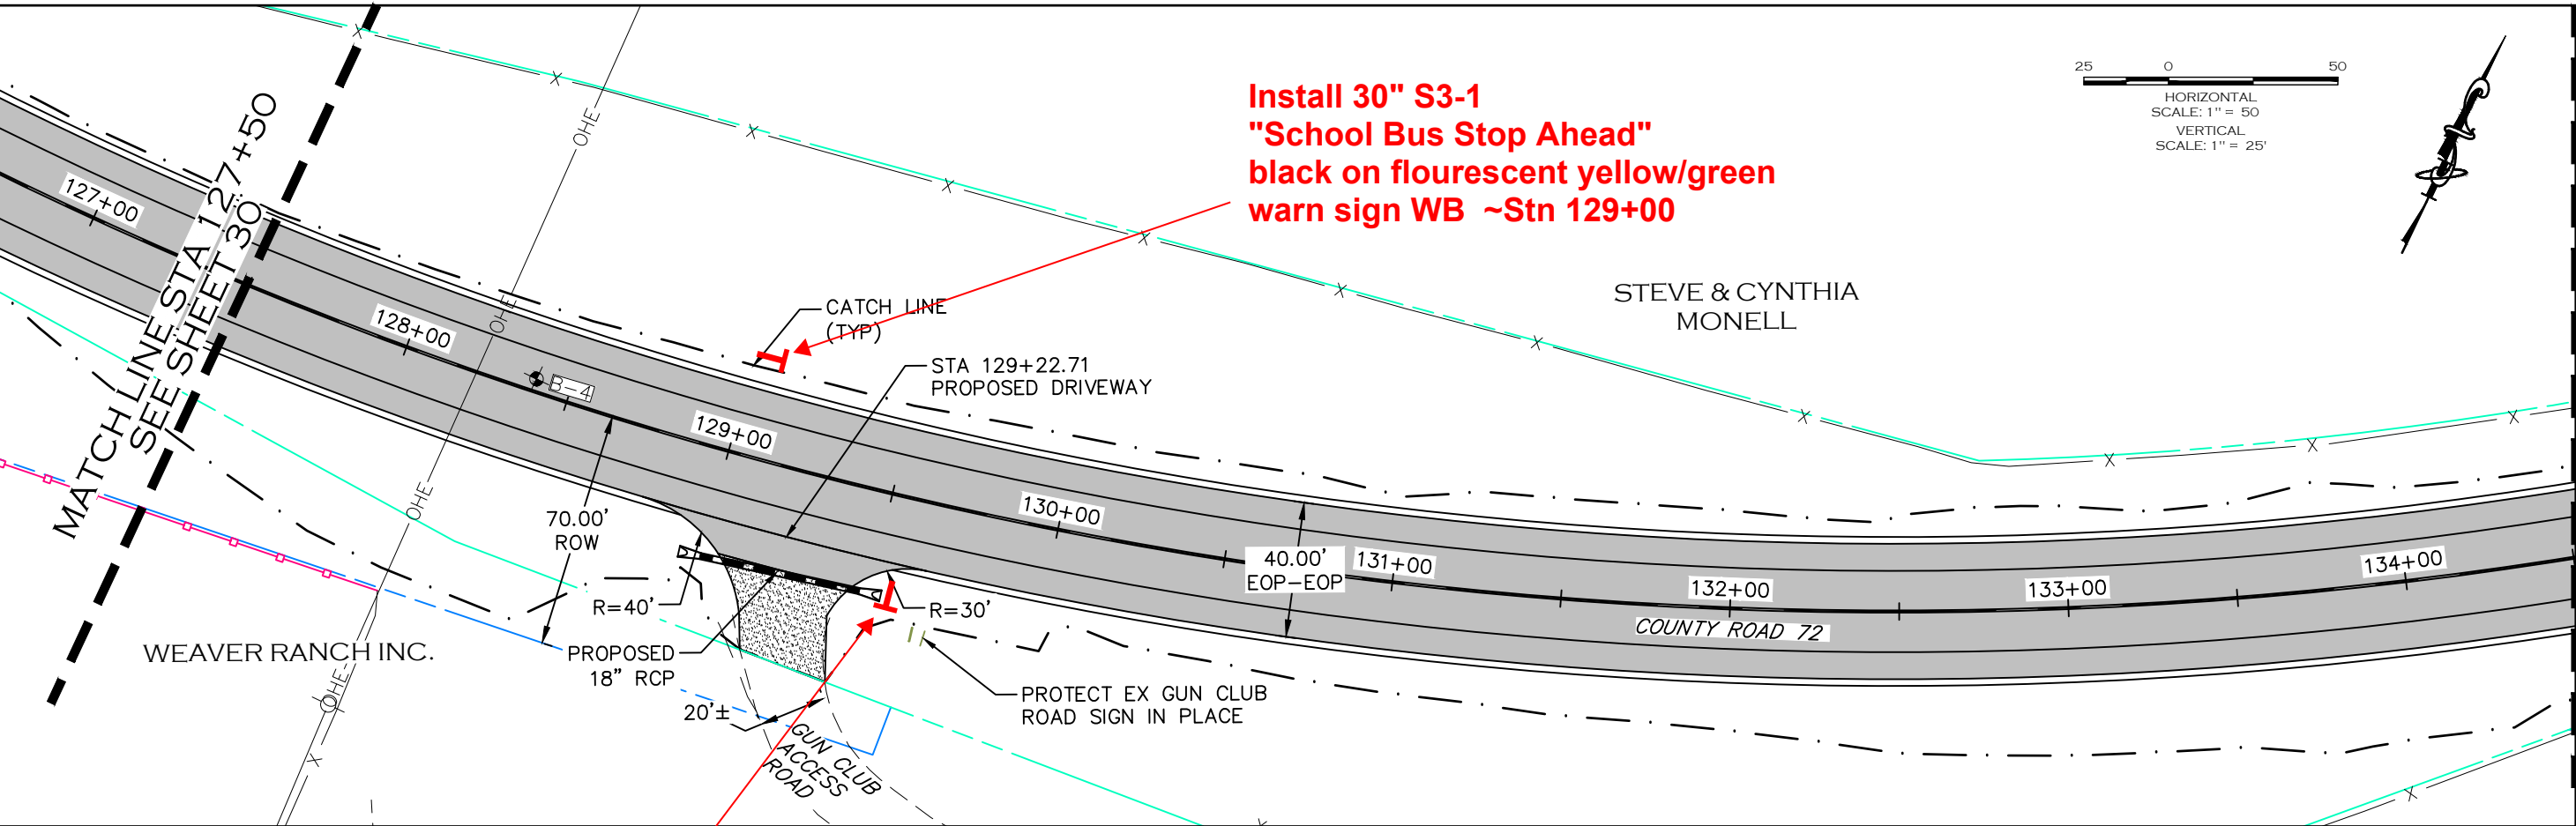


Install 30" R1-1 STOP
sign NB on Gun Club Access
Rd at CR 72 ~Stn 129+50

900.00' VC
VPI STA: 129+35.00
VPI EL=5708.49
A.D.= -10.04%
K=89.60

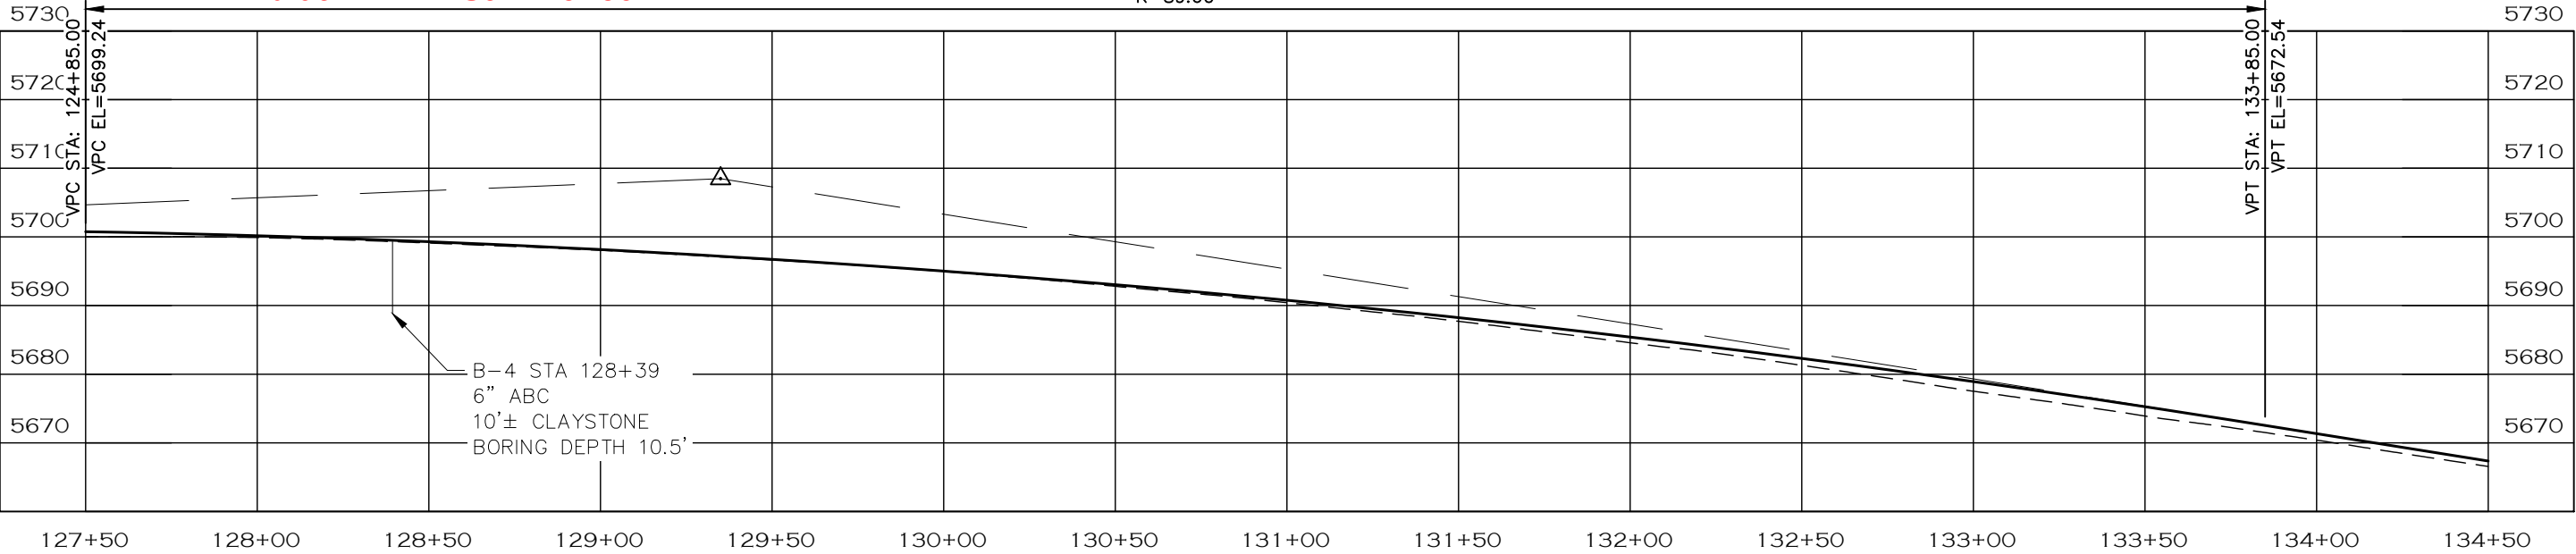


NOTE

1. ALL DRIVEWAY RADII ARE 15 FEET UNLESS OTHERWISE NOTED.
2. PROPOSED FENCE TO BE SET ON PROPOSED ROW. FENCES SHOWN 1' OFF PROPOSED ROW FOR GRAPHICAL PURPOSES.

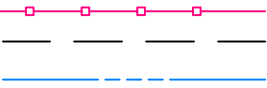

PROPOSED FENCE
TEMPORARY CONSTRUCTION EASEMENT
PROPOSED RIGHT-OF-WAY



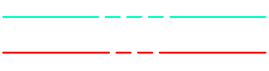


EXISTING RIGHT-OF-WAY
EXISTING PROPERTY LINE



CALL UTILITY NOTIFICATION
CENTER OF COLORADO
811
CALL 2-BUSINESS DAYS IN ADVANCE
BEFORE YOU DIG, GRADE, OR EXCAVATE
FOR THE MARKING OF UNDERGROUND
MEMBER UTILITIES.

COMPUTER INFORMATION		REVISIONS			ENGINEERING DEPARTMENT 200 WEST OAK, SUITE 3000 POST OFFICE BOX 1190 FORT COLLINS, COLORADO 80522-1190 (970)498-5700 (970)498-7986 FAX	AS CONSTRUCTED		PLAN & PROFILE STATION 127+50 TO 134+50	PROJECT NO. 335	
CREATION DATE:	07/13/20	☐ R-1				NO REVISIONS:			LARIMER COUNTY ROAD 72	
MODIFICATION DATE:	02/01/21	☐ R-2				REVISED:			SHEET NO. 31	
FILE LOCATION:	INTEREST PROJECTS\2019 PROJECTS\1421-094-00 LARIMER COUNTY ROAD 72\DRAWINGS\ENGINEERING PLANS	☐ R-3				VOID:				
FILE NAME:	1421-094-00 P&P.DWG	☐ R-4								
		☐ R-5								

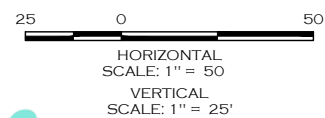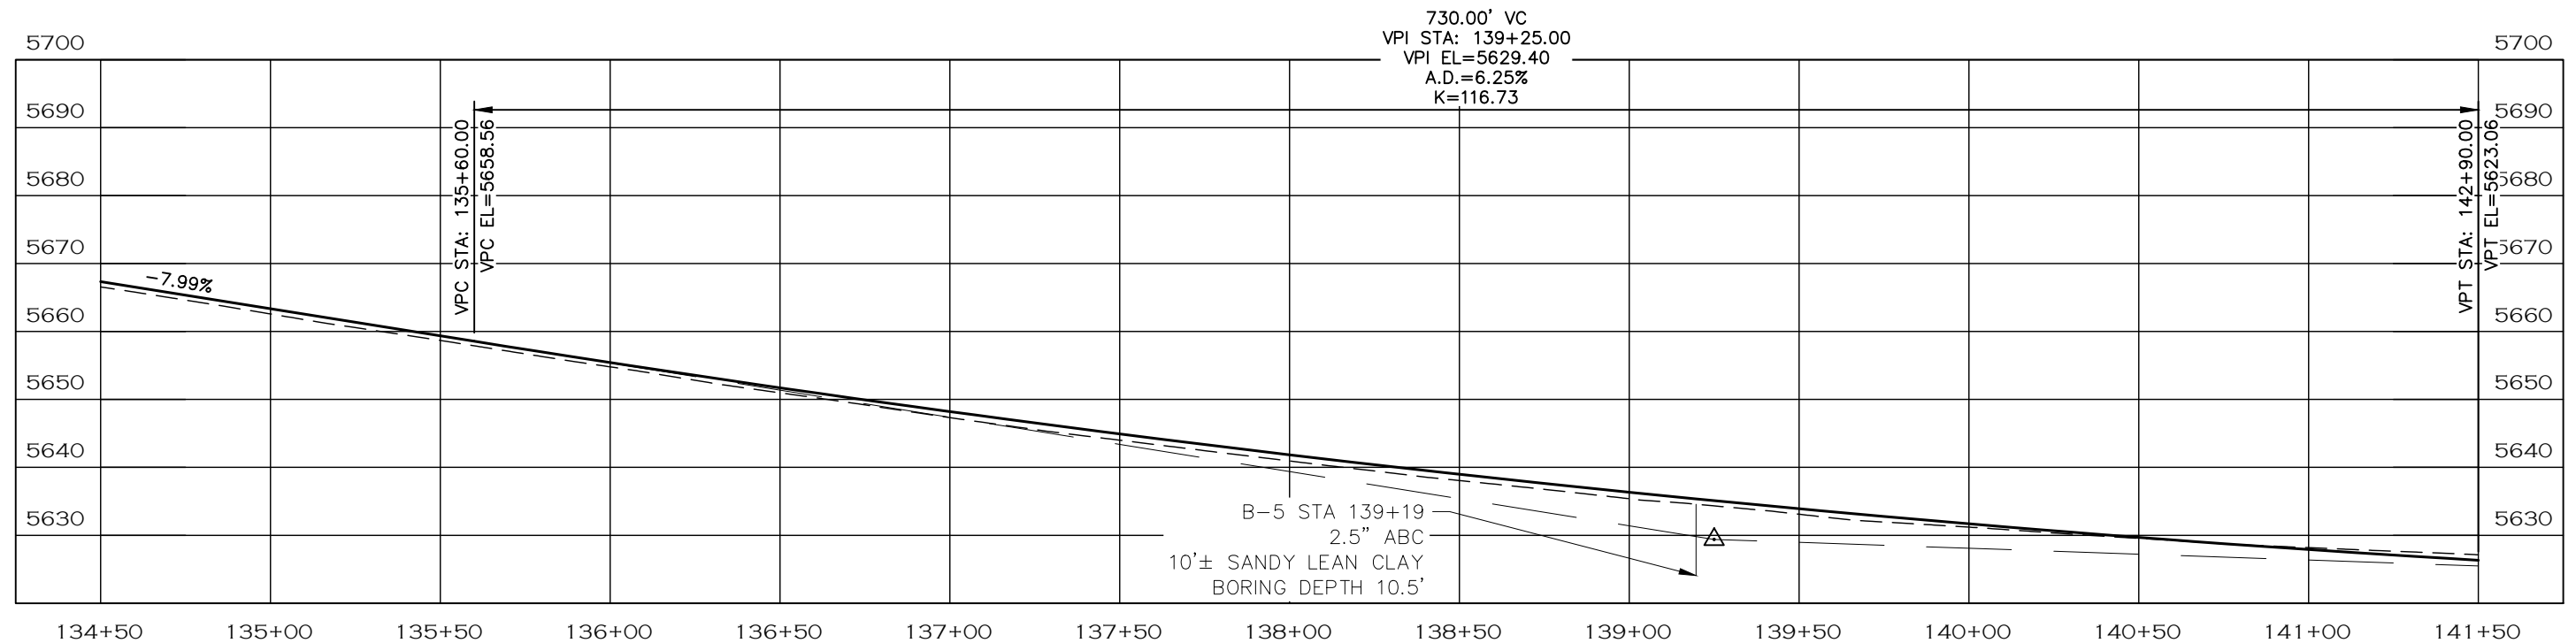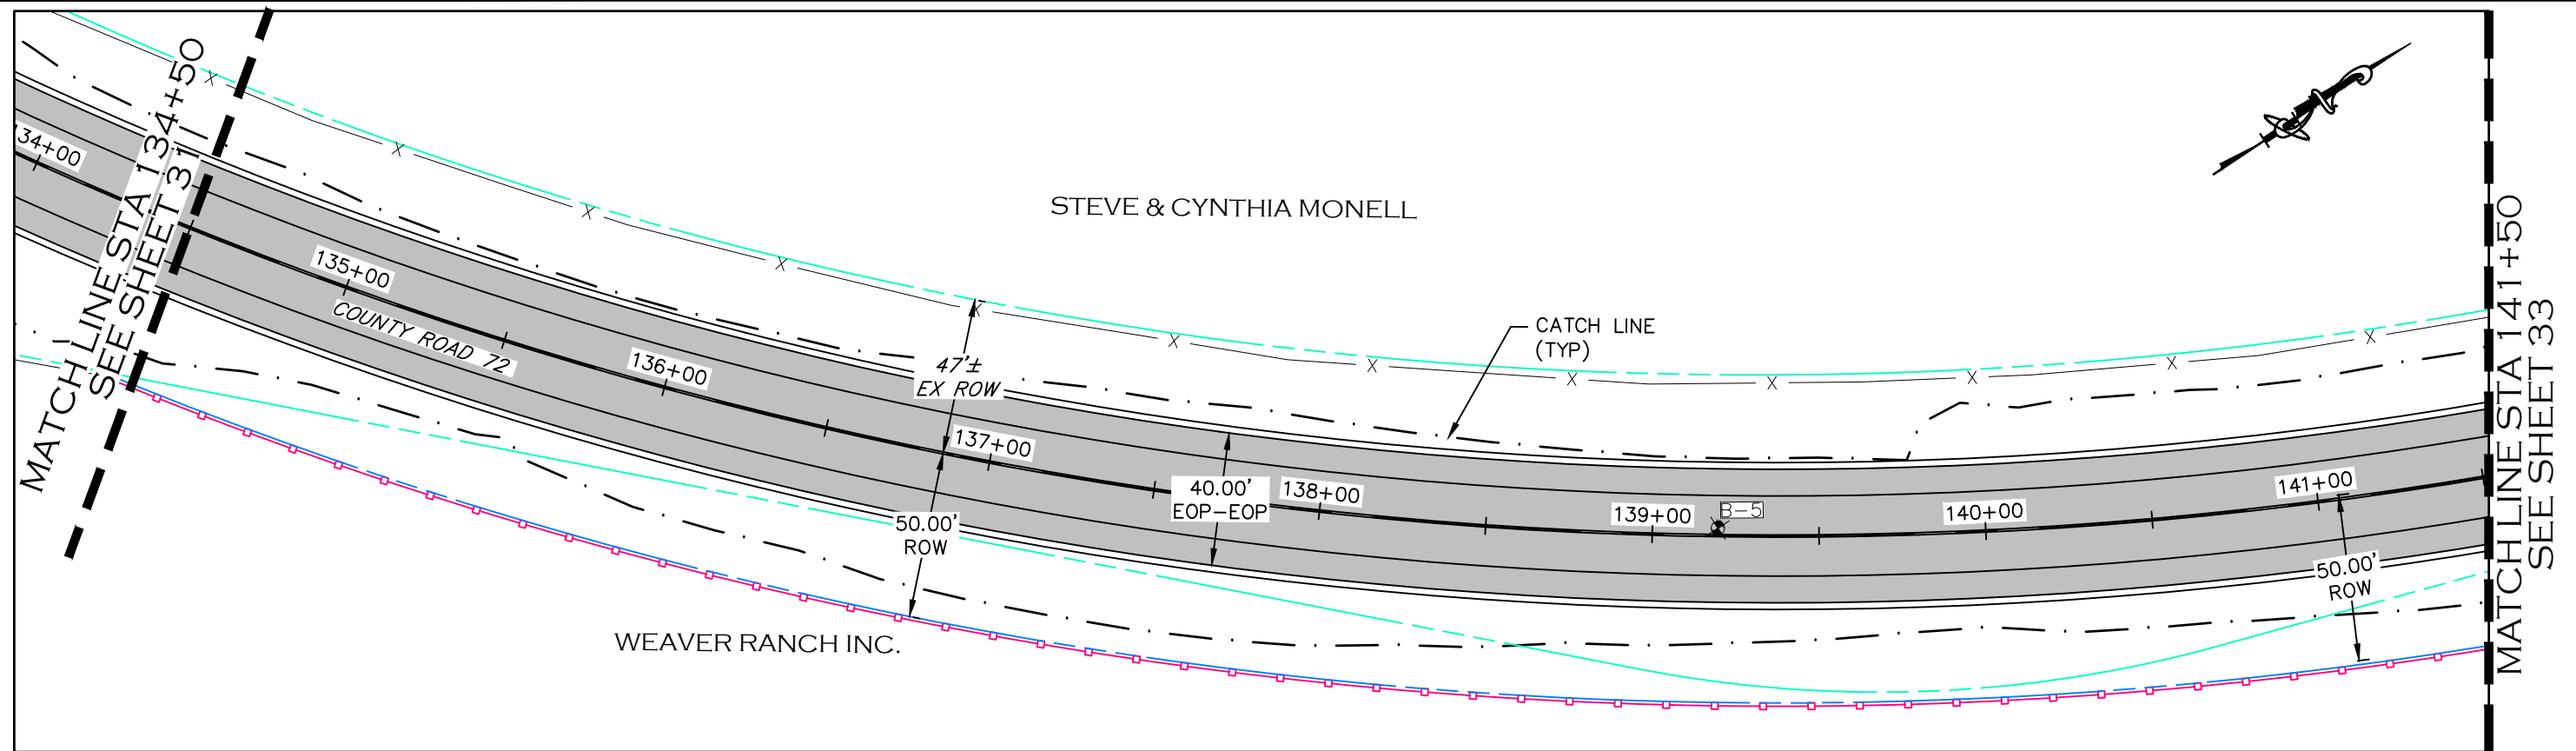

NOTE

1. ALL DRIVEWAY RADII ARE 15 FEET UNLESS OTHERWISE NOTED.
2. PROPOSED FENCE TO BE SET ON PROPOSED ROW. FENCES SHOWN 1' OFF PROPOSED ROW FOR GRAPHICAL PURPOSES.

- PROPOSED FENCE
- TEMPORARY CONSTRUCTION EASEMENT
- PROPOSED RIGHT-OF-WAY
- EXISTING RIGHT-OF-WAY
- EXISTING PROPERTY LINE

CALL UTILITY NOTIFICATION
CENTER OF COLORADO
811
CALL 2-BUSINESS DAYS IN ADVANCE
BEFORE YOU DIG, GRADE, OR EXCAVATE
FOR THE MARKING OF UNDERGROUND
MEMBER UTILITIES.

COMPUTER INFORMATION

CREATION DATE: 07/13/20
MODIFICATION DATE: 02/01/21
FILE LOCATION: I:\PROJECTS\2019 PROJECTS\1421-094-00 (LARIMER COUNTY ROAD 72)\DRAWINGS\ENGINEERING PLANS
FILE NAME: 1421-094-00 P&P.DWG

REVISIONS

R-1		
R-2		
R-3		
R-4		
R-5		



ENGINEERING DEPARTMENT

200 WEST OAK, SUITE 3000
POST OFFICE BOX 1190
FORT COLLINS, COLORADO 80522-1190
(970)498-5700
(970)498-7986 FAX

AS CONSTRUCTED




NO REVISIONS:
REVISED:
VOID:

PLAN & PROFILE
STATION 134+50 TO 141+50

PROJECT NO. 335

LARIMER COUNTY ROAD 72

SHEET NO. 32

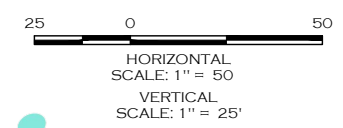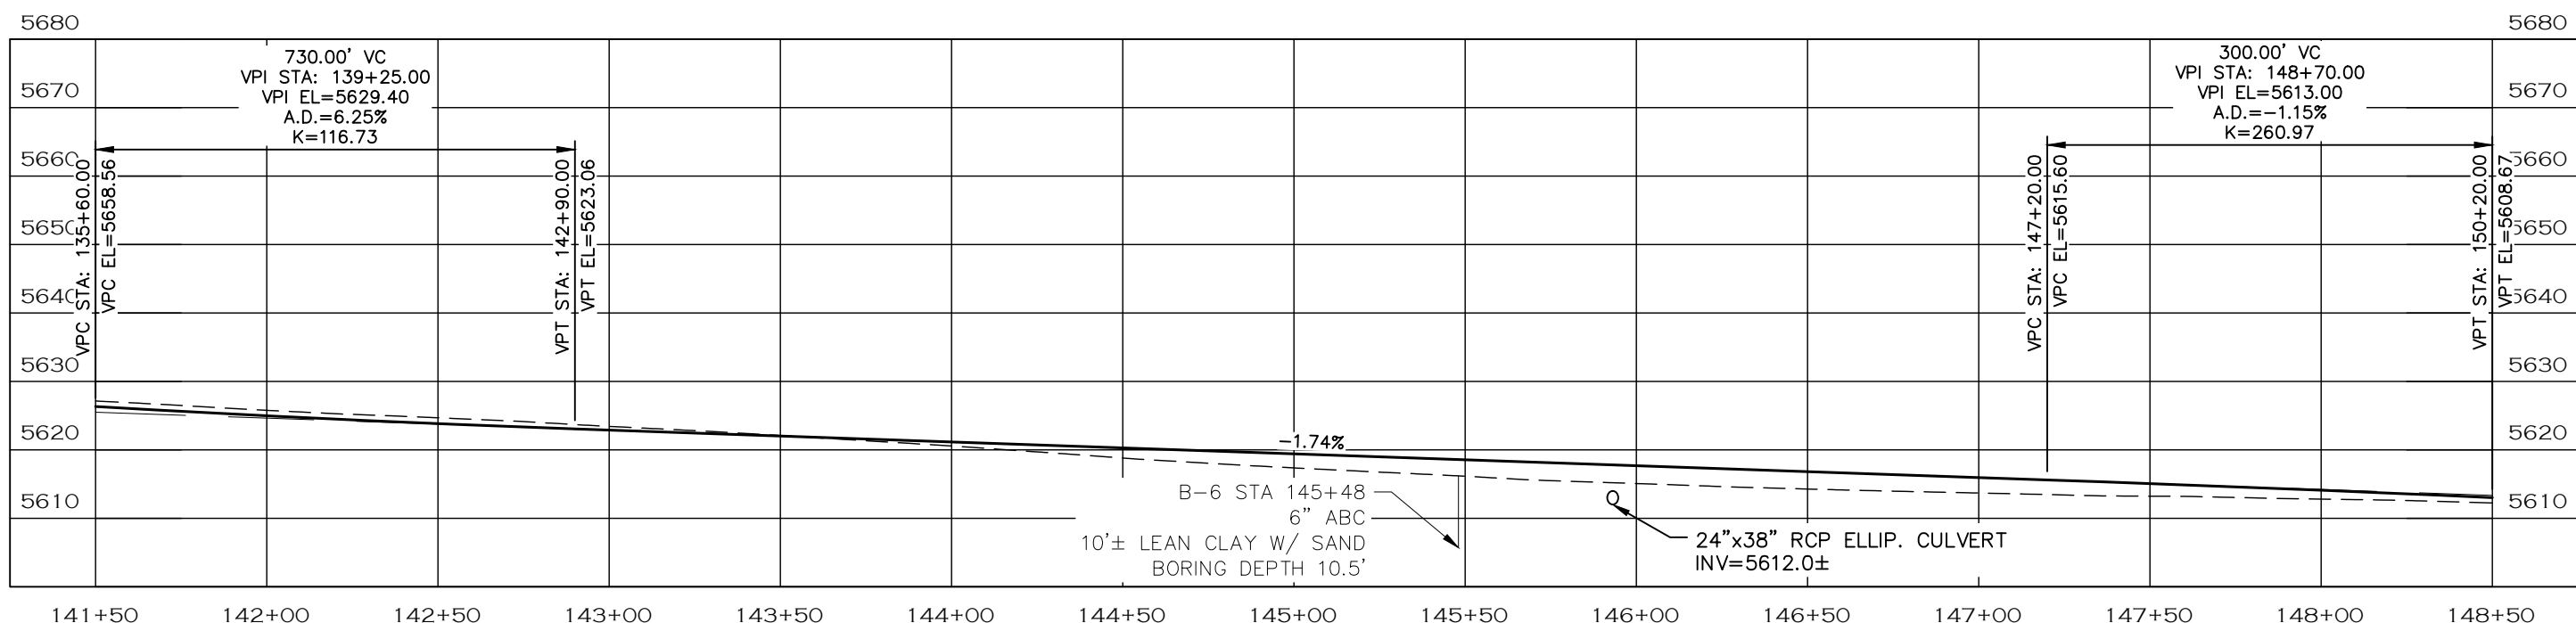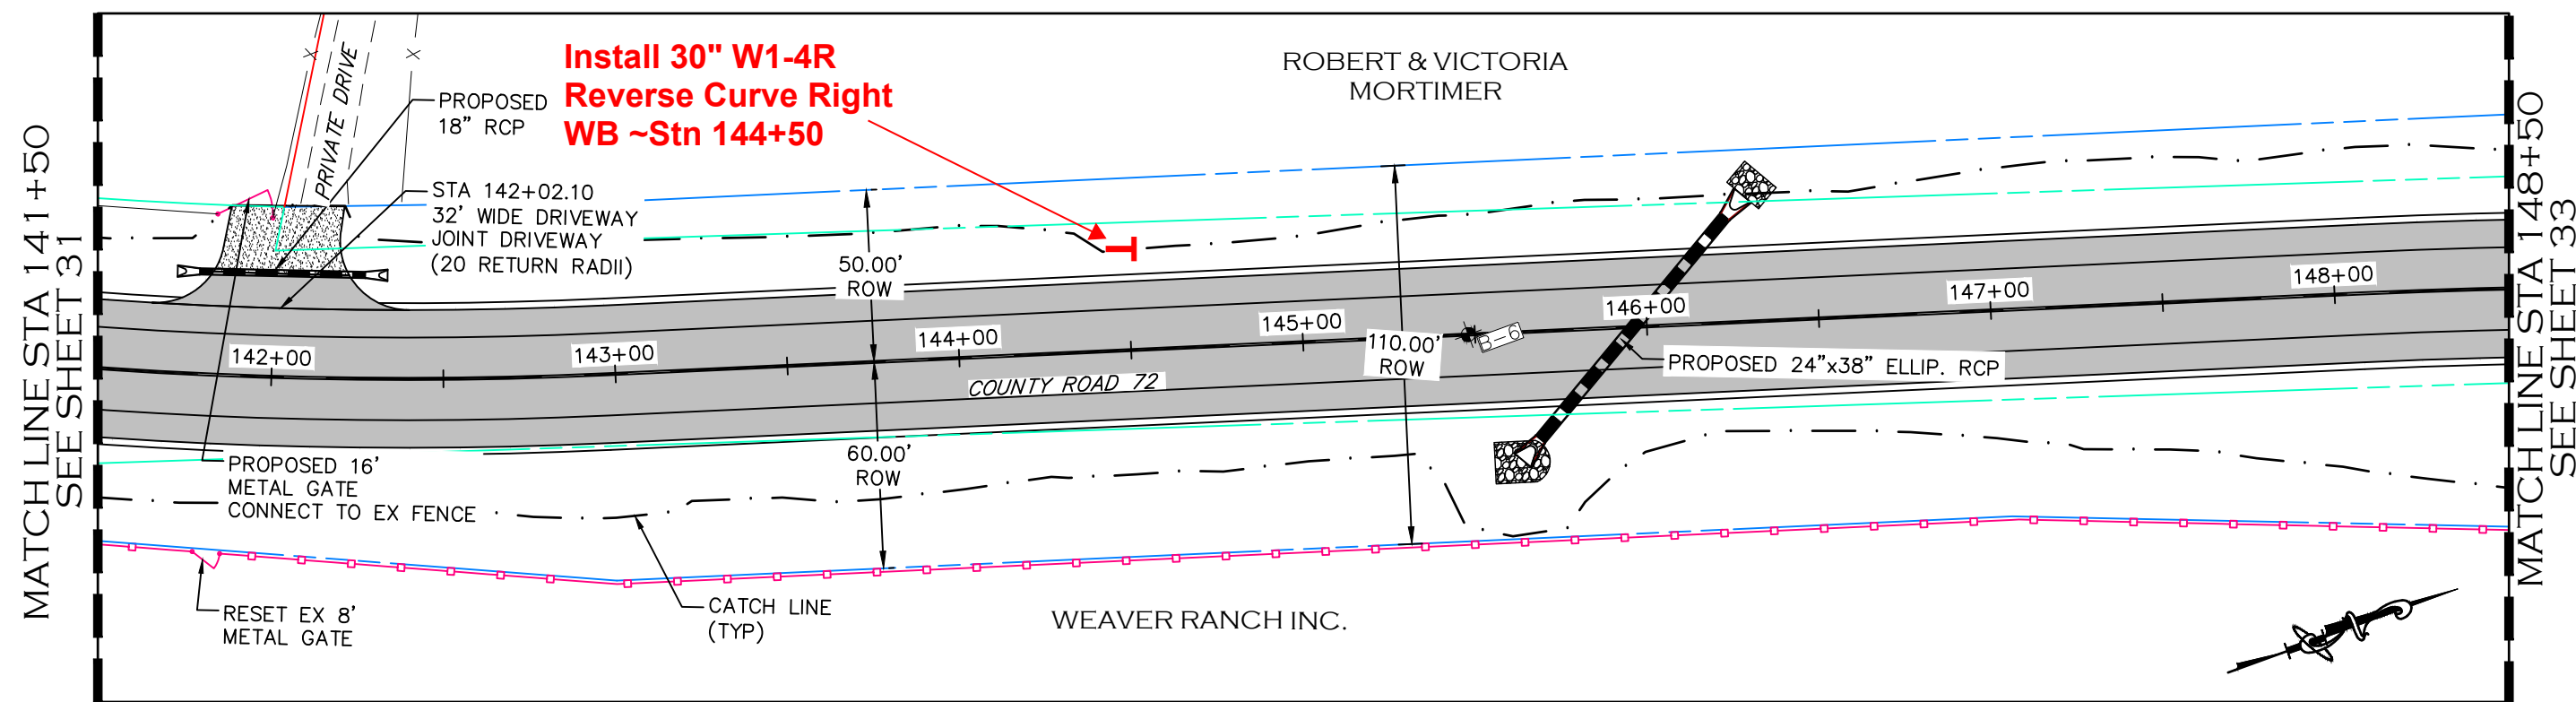




NOTE

1. ALL DRIVEWAY RADII ARE 15 FEET UNLESS OTHERWISE NOTED.
2. PROPOSED FENCE TO BE SET ON PROPOSED ROW. FENCES SHOWN 1' OFF PROPOSED ROW FOR GRAPHICAL PURPOSES.

- PROPOSED FENCE
- TEMPORARY CONSTRUCTION EASEMENT
- PROPOSED RIGHT-OF-WAY
- EXISTING RIGHT-OF-WAY
- EXISTING PROPERTY LINE

CALL UTILITY NOTIFICATION
CENTER OF COLORADO
811
CALL 2-BUSINESS DAYS IN ADVANCE
BEFORE YOU DIG, GRADE, OR EXCAVATE
FOR THE MARKING OF UNDERGROUND
MEMBER UTILITIES.

COMPUTER INFORMATION		REVISIONS			ENGINEERING DEPARTMENT 200 WEST OAK, SUITE 3000 FORT COLLINS, COLORADO 80522-1190 (970)498-5700 (970)498-7986 FAX	AS CONSTRUCTED		PLAN & PROFILE STATION 141+50 TO 148+50	PROJECT NO. 335	
CREATION DATE:	07/13/20	☐ R-1				NO REVISIONS:			LARIMER COUNTY ROAD 72	
MODIFICATION DATE:	02/01/21	☐ R-2				REVISED:			SHEET NO. 33	
FILE LOCATION:	INTEREST PROJECTS\2019 PROJECTS\1421-094-00 (LARIMER COUNTY ROAD 72)\DRAWINGS\ENGINEERING PLANS	☐ R-3								
FILE NAME:	1421-094-00 P&P.DWG	☐ R-4								
		☐ R-5								

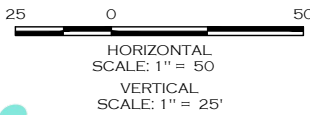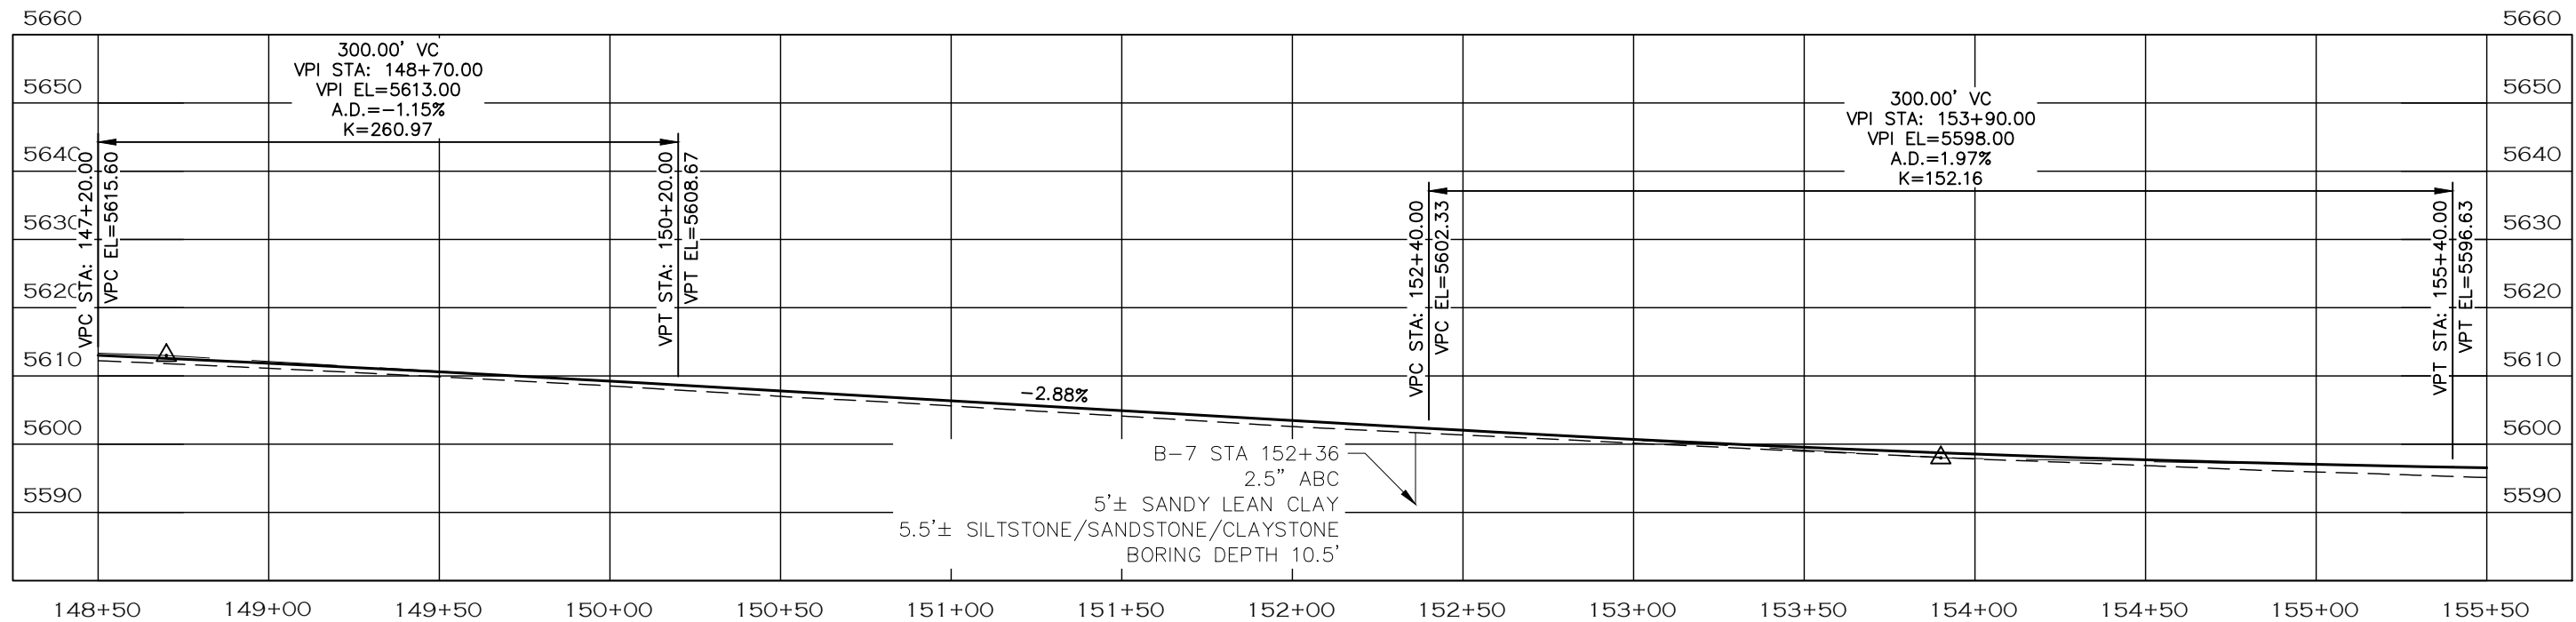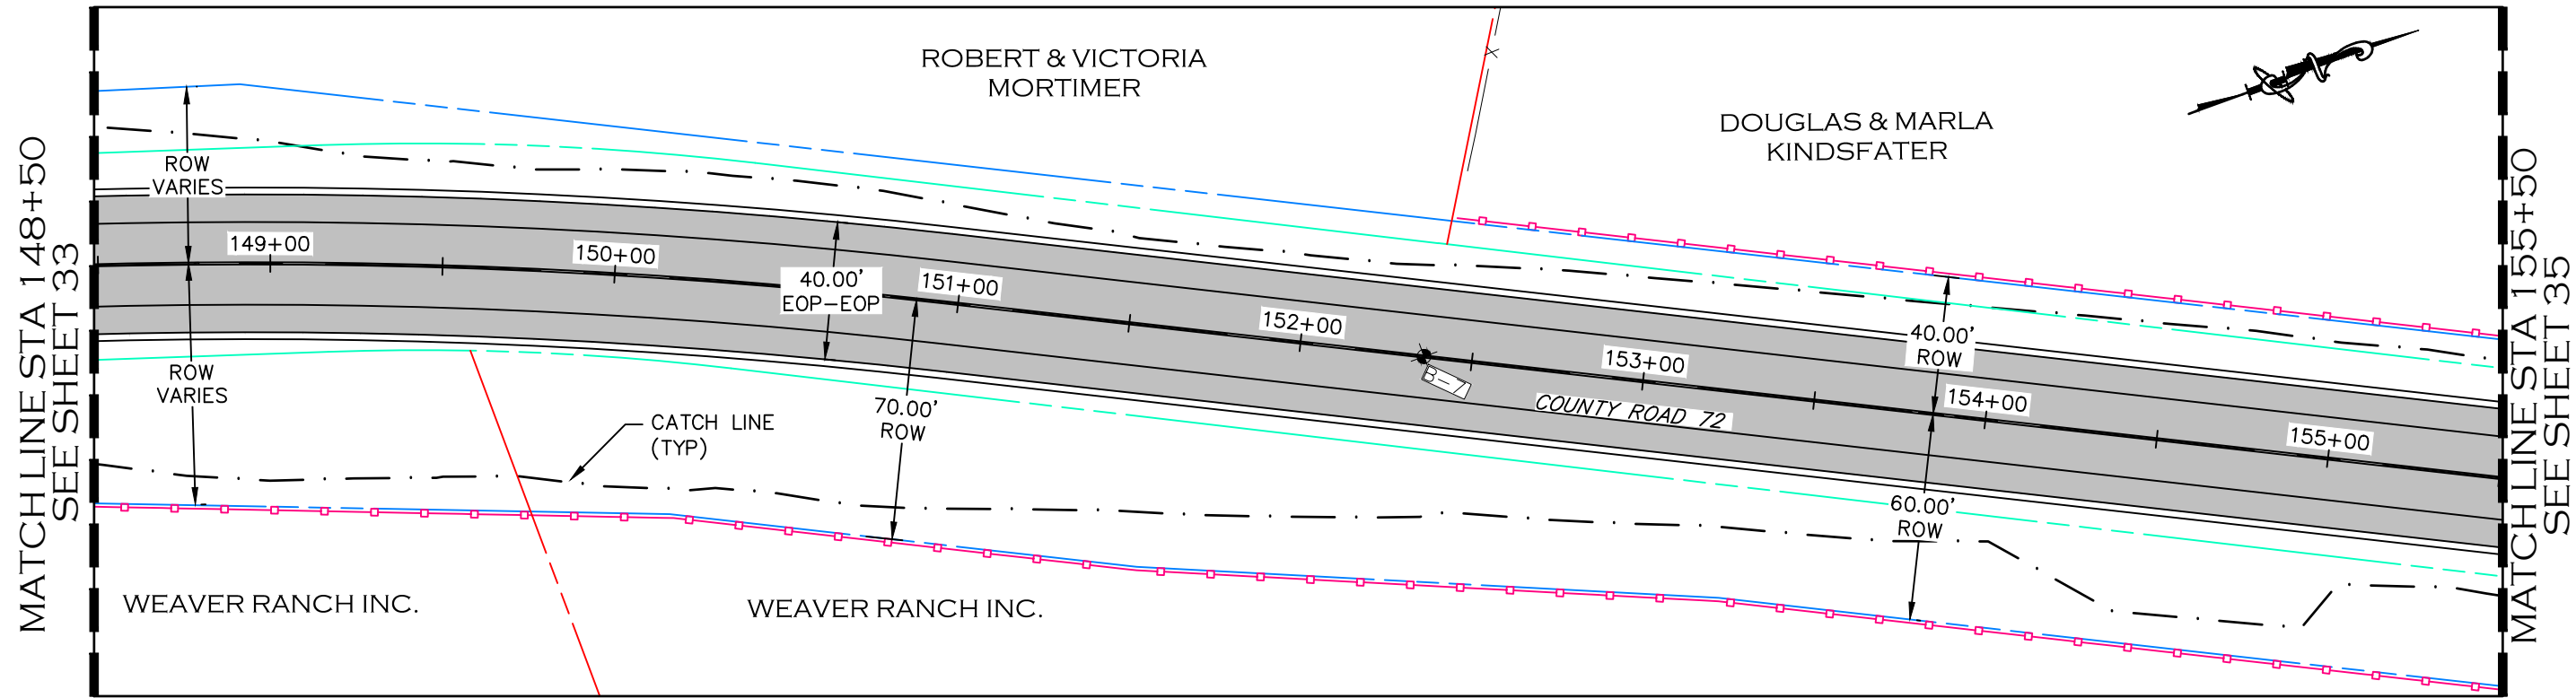




NOTE

1. ALL DRIVEWAY RADII ARE 15 FEET UNLESS OTHERWISE NOTED.
2. PROPOSED FENCE TO BE SET ON PROPOSED ROW. FENCES SHOWN 1' OFF PROPOSED ROW FOR GRAPHICAL PURPOSES.

- PROPOSED FENCE
- TEMPORARY CONSTRUCTION EASEMENT
- PROPOSED RIGHT-OF-WAY
- EXISTING RIGHT-OF-WAY
- EXISTING PROPERTY LINE

CALL UTILITY NOTIFICATION
CENTER OF COLORADO
811
CALL 2-BUSINESS DAYS IN ADVANCE
BEFORE YOU DIG, GRADE, OR EXCAVATE
FOR THE MARKING OF UNDERGROUND
MEMBER UTILITIES.

COMPUTER INFORMATION		REVISIONS				ENGINEERING DEPARTMENT 200 WEST OAK, SUITE 3000 POST OFFICE BOX 1190 FORT COLLINS, COLORADO 80522-1190 (970)498-5700 (970)498-7986 FAX	AS CONSTRUCTED		PLAN & PROFILE STATION 148+50 TO 155+50	PROJECT NO. 335	
CREATION DATE:	07/13/20	☐ R-1					NO REVISIONS:			LARIMER COUNTY ROAD 72	
MODIFICATION DATE:	02/01/21	☐ R-2					REVISED:			SHEET NO. 34	
FILE LOCATION:	INTEREST PROJECTS\2019 PROJECTS\1421-094-00 (LARIMER COUNTY ROAD 72)\DRAWINGS\ENGINEERING PLANS	☐ R-3									
FILE NAME:	1421-094-00 P&P.DWG	☐ R-4									
		☐ R-5			VOID:						

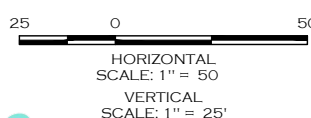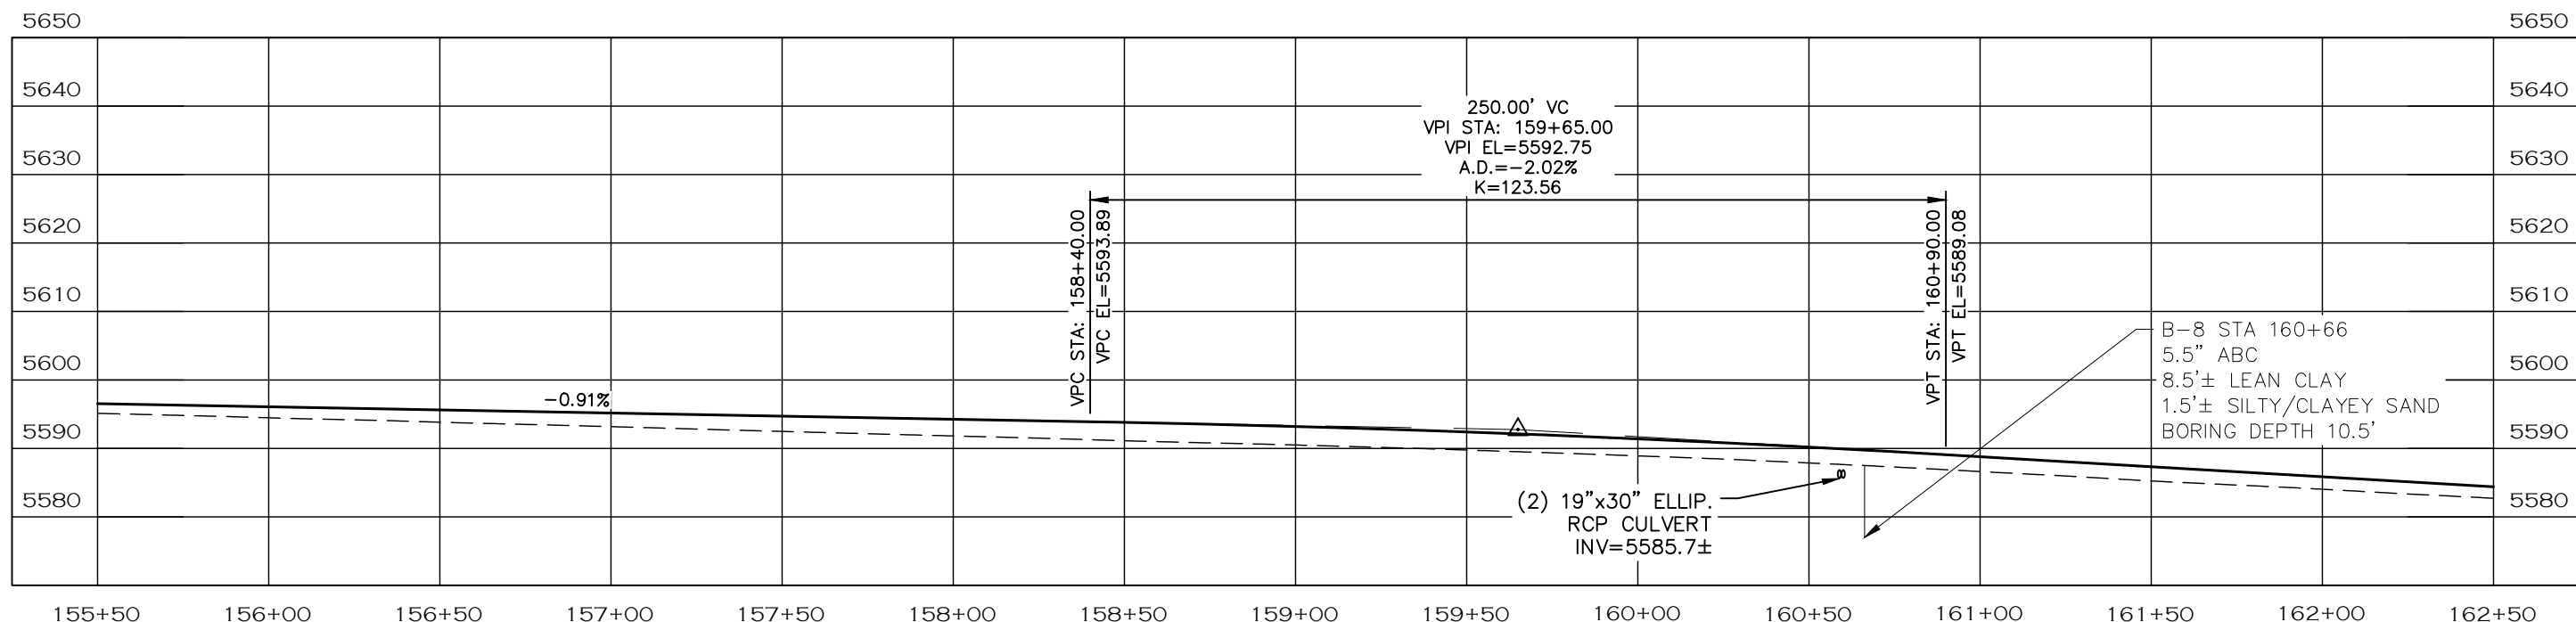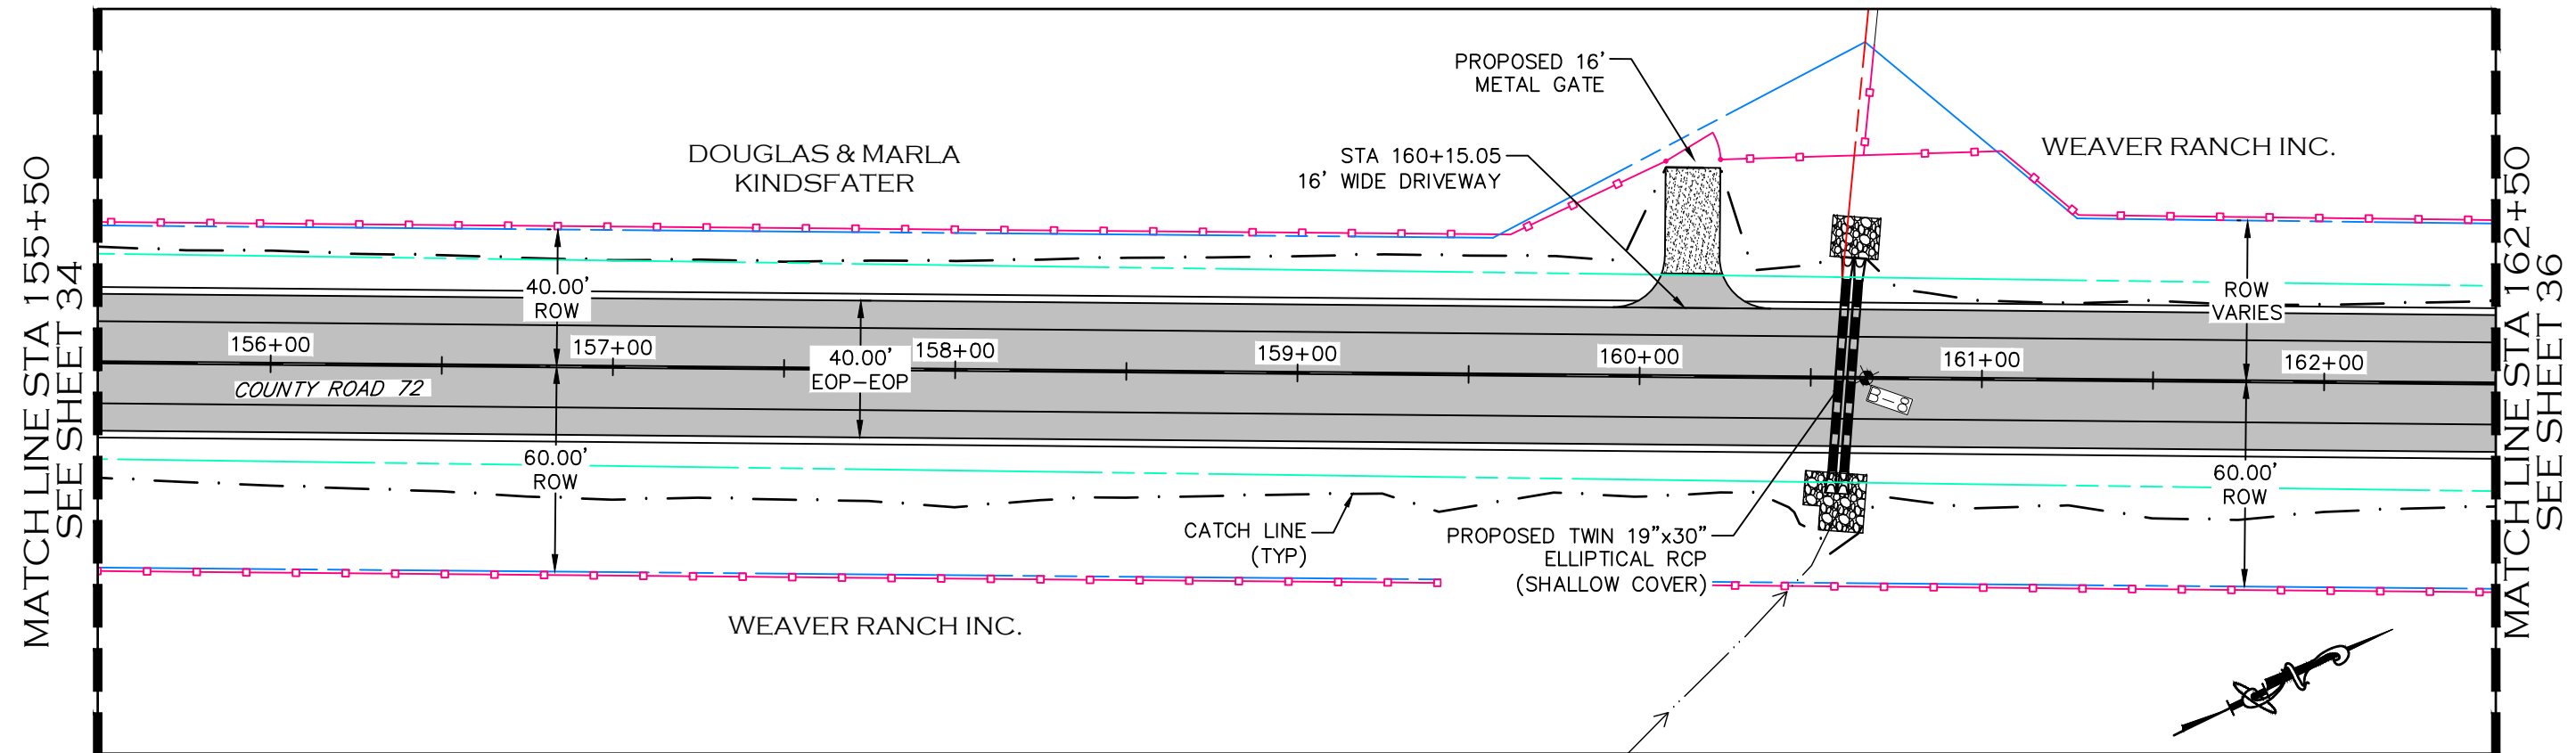


NOTE

1. ALL DRIVEWAY RADII ARE 15 FEET UNLESS OTHERWISE NOTED.
2. PROPOSED FENCE TO BE SET ON PROPOSED ROW. FENCES SHOWN 1' OFF PROPOSED ROW FOR GRAPHICAL PURPOSES.

- PROPOSED FENCE
- TEMPORARY CONSTRUCTION EASEMENT
- PROPOSED RIGHT-OF-WAY
- EXISTING RIGHT-OF-WAY
- EXISTING PROPERTY LINE

CALL UTILITY NOTIFICATION
CENTER OF COLORADO
811
CALL 2-BUSINESS DAYS IN ADVANCE
BEFORE YOU DIG, GRADE, OR EXCAVATE
FOR THE MARKING OF UNDERGROUND
MEMBER UTILITIES.




COMPUTER INFORMATION		REVISIONS			ENGINEERING DEPARTMENT 200 WEST OAK, SUITE 3000 POST OFFICE BOX 1190 FORT COLLINS, COLORADO 80522-1190 (970)498-5700 (970)498-7986 FAX	AS CONSTRUCTED		PLAN & PROFILE STATION 155+50 TO 162+50	PROJECT NO. 335	
CREATION DATE:	07/13/20	☐ R-1				NO REVISIONS:			LARIMER COUNTY ROAD 72	
MODIFICATION DATE:	02/01/21	☐ R-2				REVISED:			SHEET NO. 35	
FILE LOCATION:	INTEREST PROJECTS\2019 PROJECTS\1421-094-00 (LARIMER COUNTY ROAD 72)\DRAWINGS\ENGINEERING PLANS	☐ R-3								
FILE NAME:	1421-094-00 P&P.DWG	☐ R-4								
		☐ R-5								

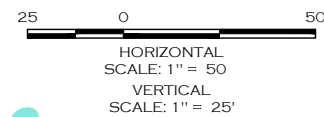

CALL UTILITY NOTIFICATION
CENTER OF COLORADO
811
CALL 2-BUSINESS DAYS IN ADVANCE
BEFORE YOU DIG, GRADE, OR EXCAVATE
FOR THE MARKING OF UNDERGROUND
MEMBER UTILITIES.

COMPUTER INFORMATION		REVISIONS		 LARIMER COUNTY ENGINEERING DEPARTMENT 200 WEST OAK, SUITE 3000 POST OFFICE BOX 1190 FORT COLLINS, COLORADO 80522-1190 (970)498-5700 (970)498-7986 FAX	AS CONSTRUCTED		PLAN & PROFILE STATION 162+50 TO 169+50	PROJECT NO. 335	
CREATION DATE:	07/13/20	☐ R-1			NO REVISIONS:			LARIMER COUNTY ROAD 72	
MODIFICATION DATE:	02/01/21	☐ R-2			REVISED:				
FILE LOCATION:	INTEREST PROJECTS\2019 PROJECTS\1421-094-00 \LARIMER COUNTY ROAD 72\DRAWINGS\ENGINEERING PLANS	☐ R-3			VOID:				
FILE NAME:	1421-094-00 P&P.DWG	☐ R-4							
		☐ R-5							
							SHEET NO.	36	

MATCHLINE STA 169+50
SEE SHEET 36

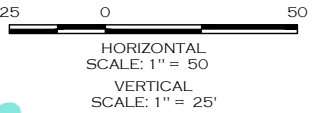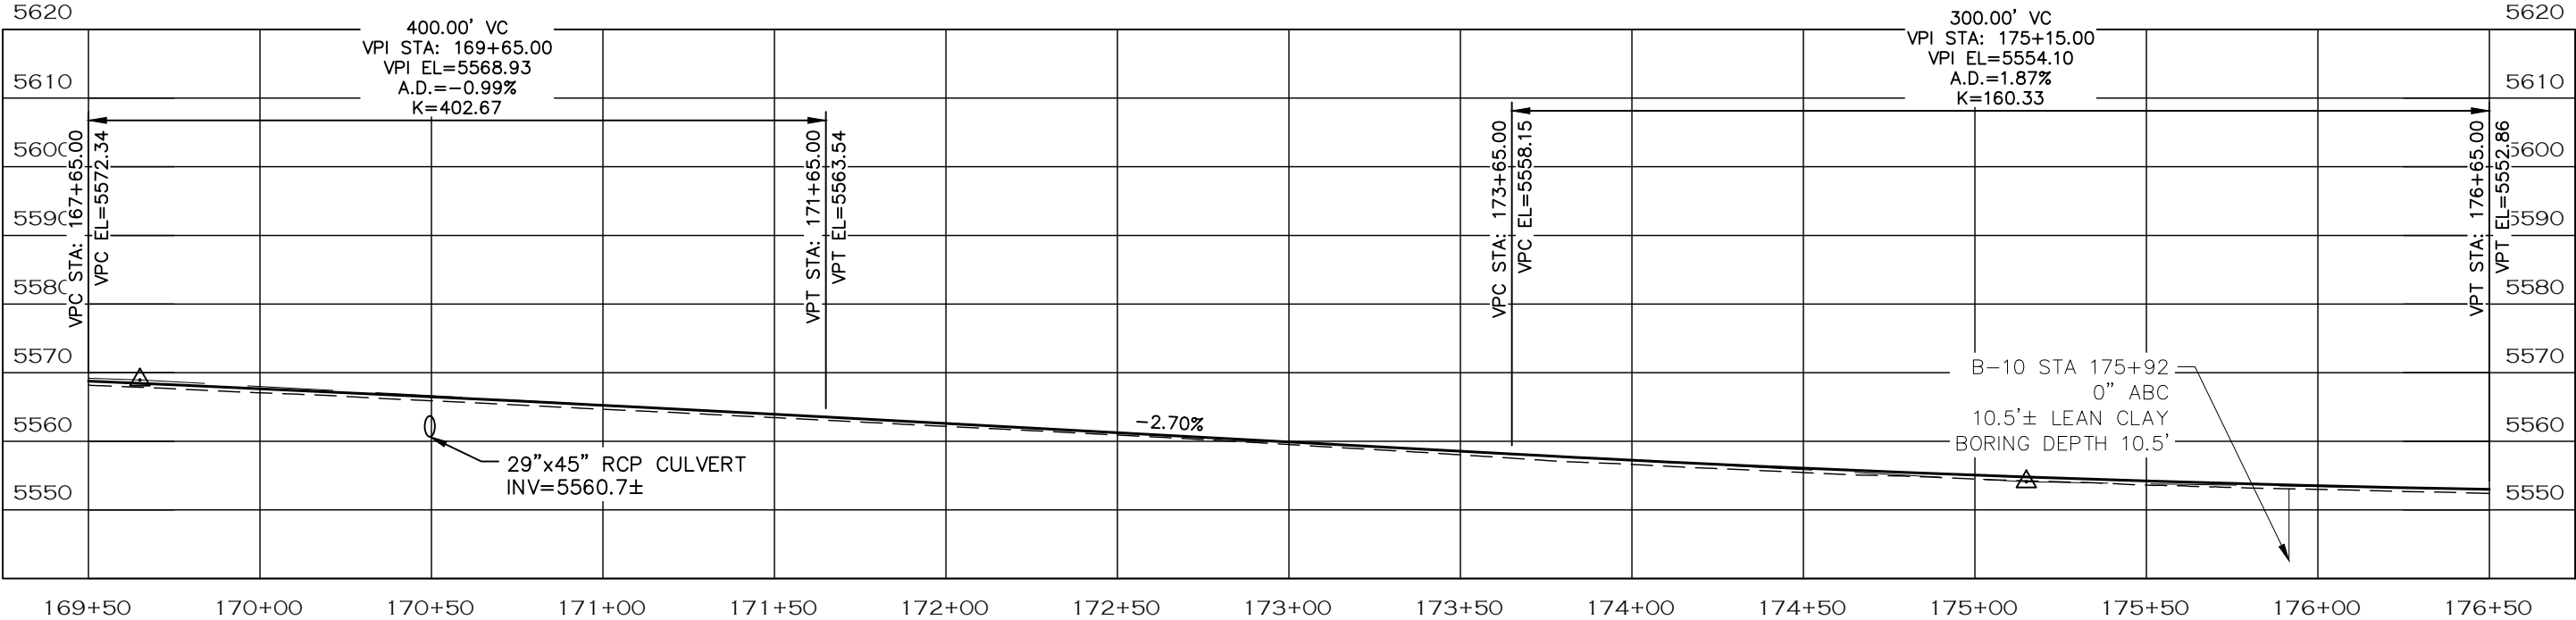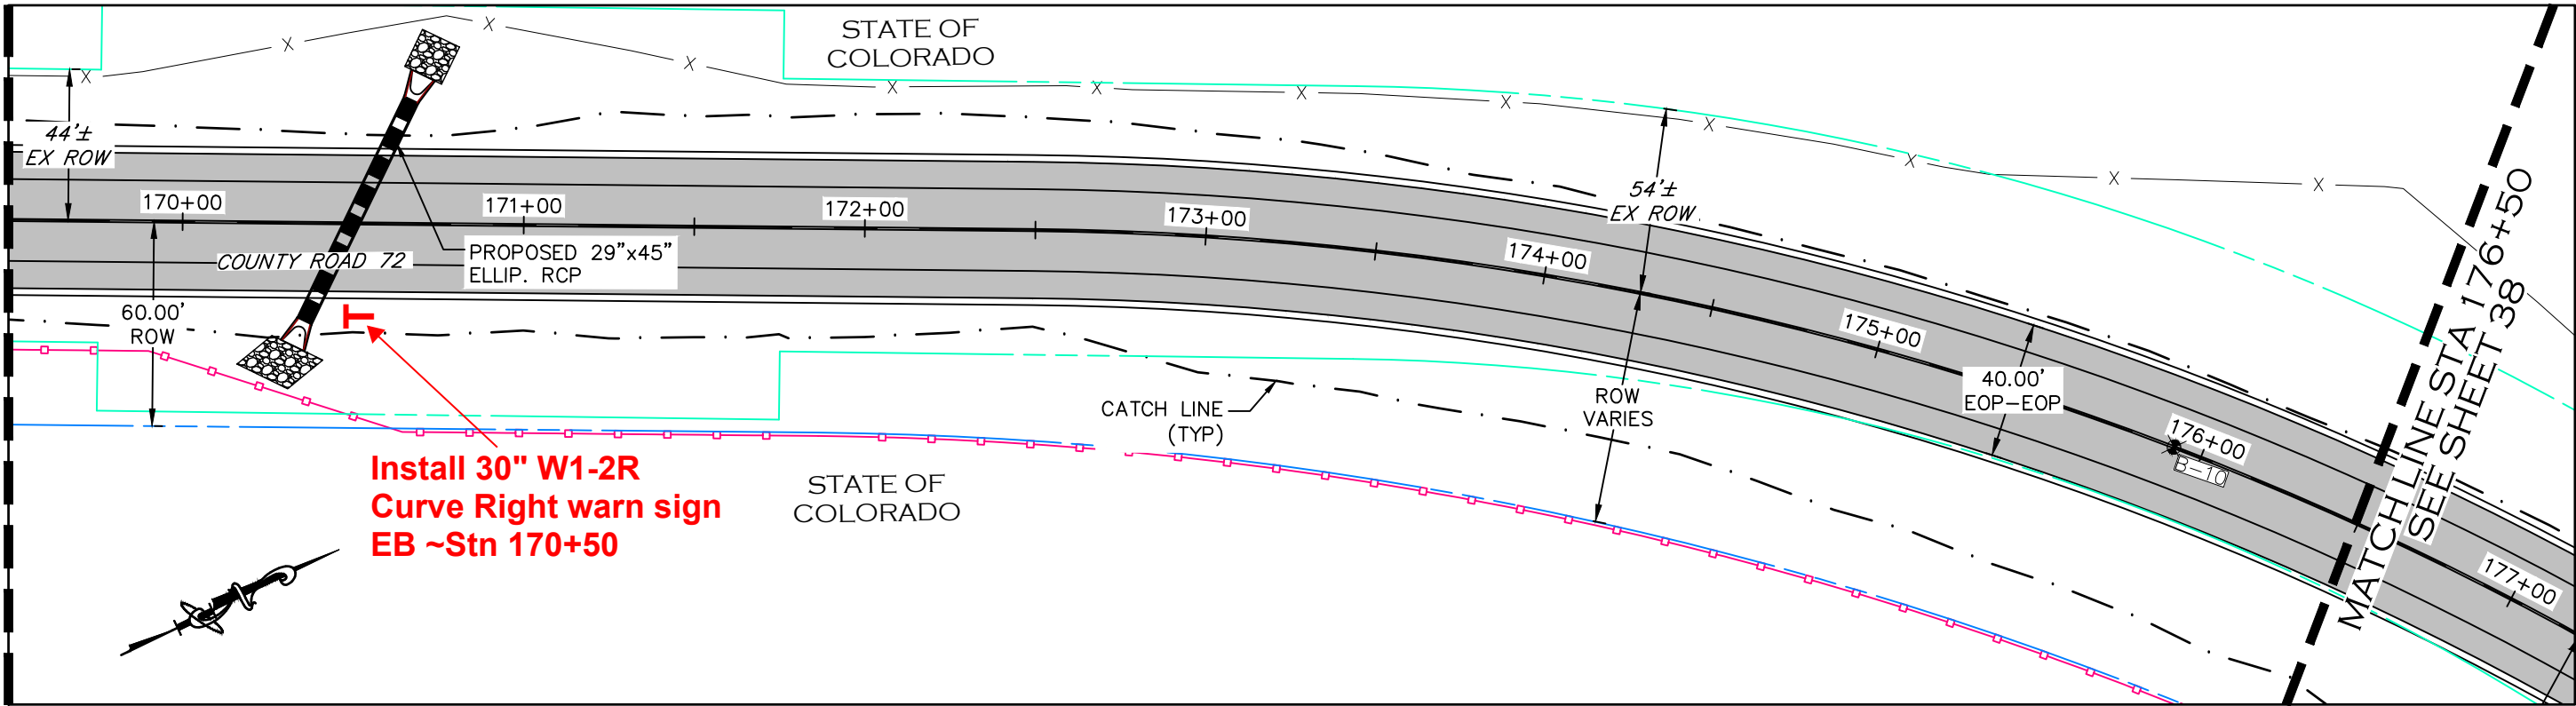




NOTE

1. ALL DRIVEWAY RADII ARE 15 FEET UNLESS OTHERWISE NOTED.
2. PROPOSED FENCE TO BE SET ON PROPOSED ROW. FENCES SHOWN 1' OFF PROPOSED ROW FOR GRAPHICAL PURPOSES.

- PROPOSED FENCE
- TEMPORARY CONSTRUCTION EASEMENT
- PROPOSED RIGHT-OF-WAY
- EXISTING RIGHT-OF-WAY
- EXISTING PROPERTY LINE

CALL UTILITY NOTIFICATION
CENTER OF COLORADO
811
CALL 2-BUSINESS DAYS IN ADVANCE
BEFORE YOU DIG, GRADE, OR EXCAVATE
FOR THE MARKING OF UNDERGROUND
MEMBER UTILITIES.

COMPUTER INFORMATION		REVISIONS			ENGINEERING DEPARTMENT 200 WEST OAK, SUITE 3000 POST OFFICE BOX 1190 FORT COLLINS, COLORADO 80522-1190 (970)498-5700 (970)498-7986 FAX	AS CONSTRUCTED		PLAN & PROFILE STATION 169+50 TO 176+50	PROJECT NO. 335	
CREATION DATE:	07/13/20	☐ R-1				NO REVISIONS:			LARIMER COUNTY ROAD 72	
MODIFICATION DATE:	02/01/21	☐ R-2				REVISED:			SHEET NO. 37	
FILE LOCATION:	INTEREST PROJECTS\2019 PROJECTS\1421-094-00 (LARIMER COUNTY ROAD 72)\DRAWINGS\ENGINEERING PLANS	☐ R-3				VOID:				
FILE NAME:	1421-094-00 P&P.DWG	☐ R-4								
		☐ R-5								

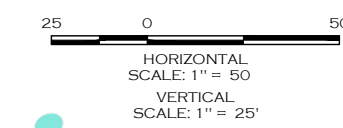
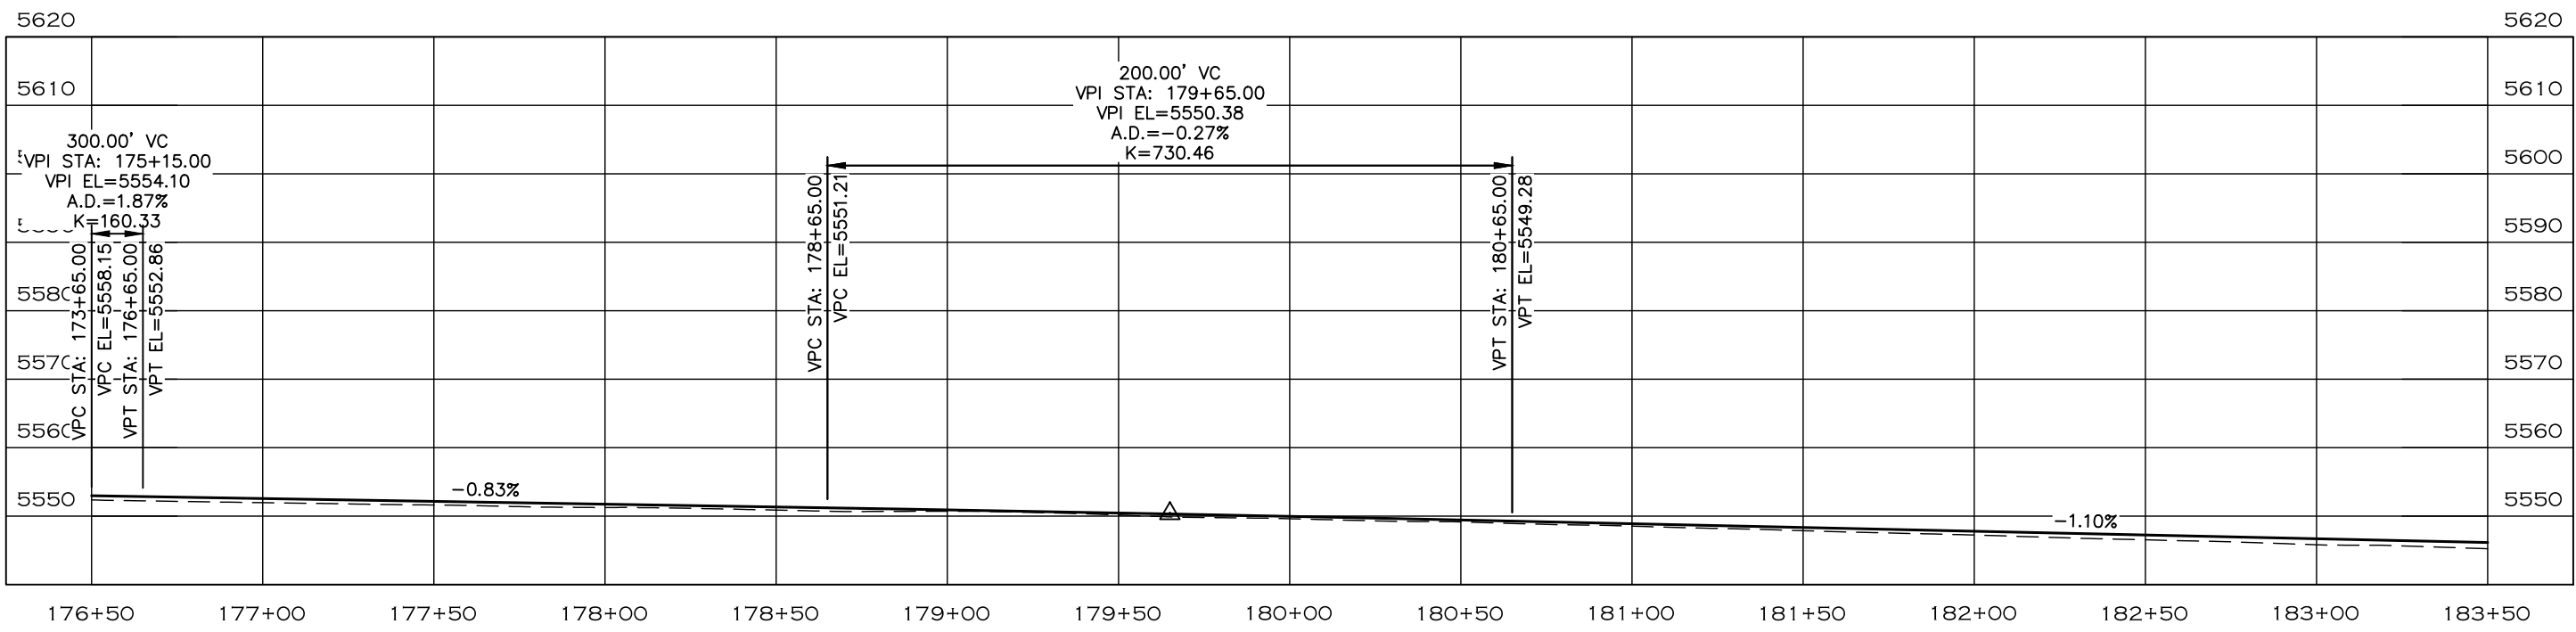
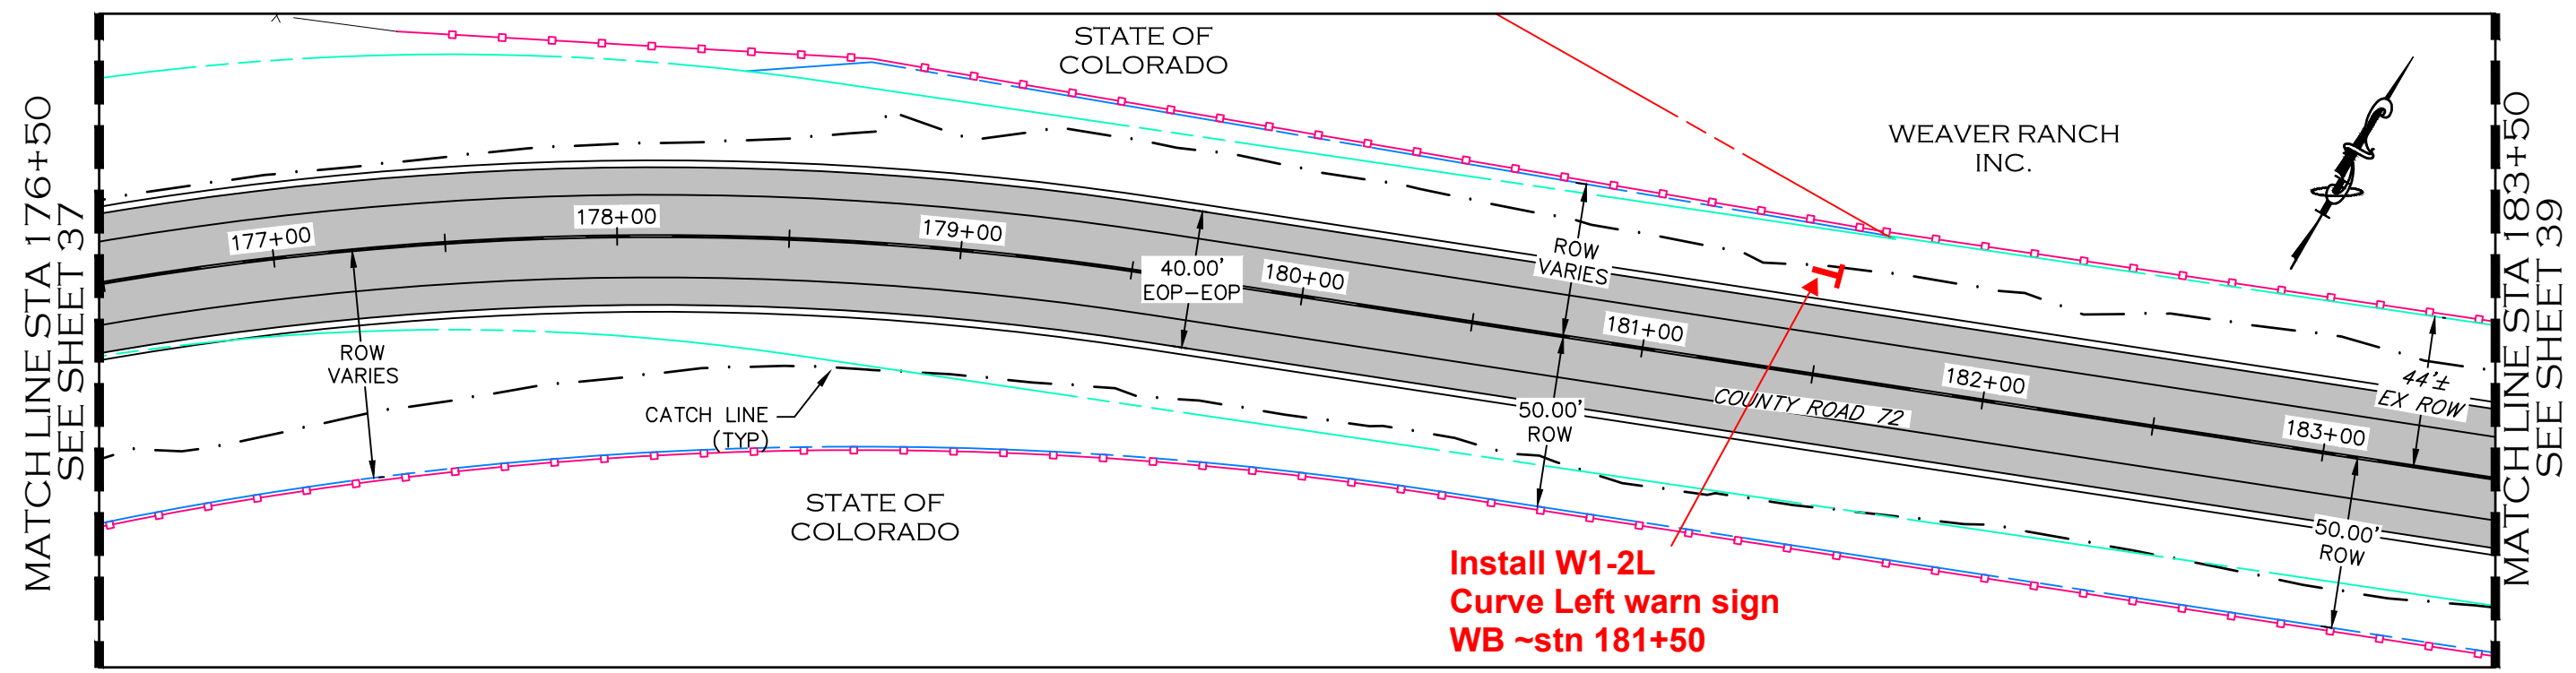


- NOTE**
1. ALL DRIVEWAY RADII ARE 15 FEET UNLESS OTHERWISE NOTED.
 2. PROPOSED FENCE TO BE SET ON PROPOSED ROW. FENCES SHOWN 1' OFF PROPOSED ROW FOR GRAPHICAL PURPOSES.

- PROPOSED FENCE
- TEMPORARY CONSTRUCTION EASEMENT
- PROPOSED RIGHT-OF-WAY
- EXISTING RIGHT-OF-WAY
- EXISTING PROPERTY LINE

CALL UTILITY NOTIFICATION
CENTER OF COLORADO
811
CALL 2-BUSINESS DAYS IN ADVANCE
BEFORE YOU DIG, GRADE, OR EXCAVATE
FOR THE MARKING OF UNDERGROUND
MEMBER UTILITIES.

COMPUTER INFORMATION		REVISIONS			ENGINEERING DEPARTMENT 200 WEST OAK, SUITE 3000 POST OFFICE BOX 1190 FORT COLLINS, COLORADO 80522-1190 (970)498-5700 (970)498-7986 FAX	AS CONSTRUCTED		PLAN & PROFILE STATION 176+50 TO 183+50	PROJECT NO. 335	
CREATION DATE:	07/13/20	☐ R-1				NO REVISIONS:			LARIMER COUNTY ROAD 72	
MODIFICATION DATE:	02/01/21	☐ R-2				REVISED:			SHEET NO. 38	
FILE LOCATION:	INTEREST PROJECTS\2019 PROJECTS\1421-094-00 LARIMER COUNTY ROAD 72\DRAWINGS\ENGINEERING PLANS	☐ R-3								
FILE NAME:	1421-094-00 P&P.DWG	☐ R-4								
		☐ R-5								

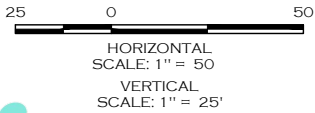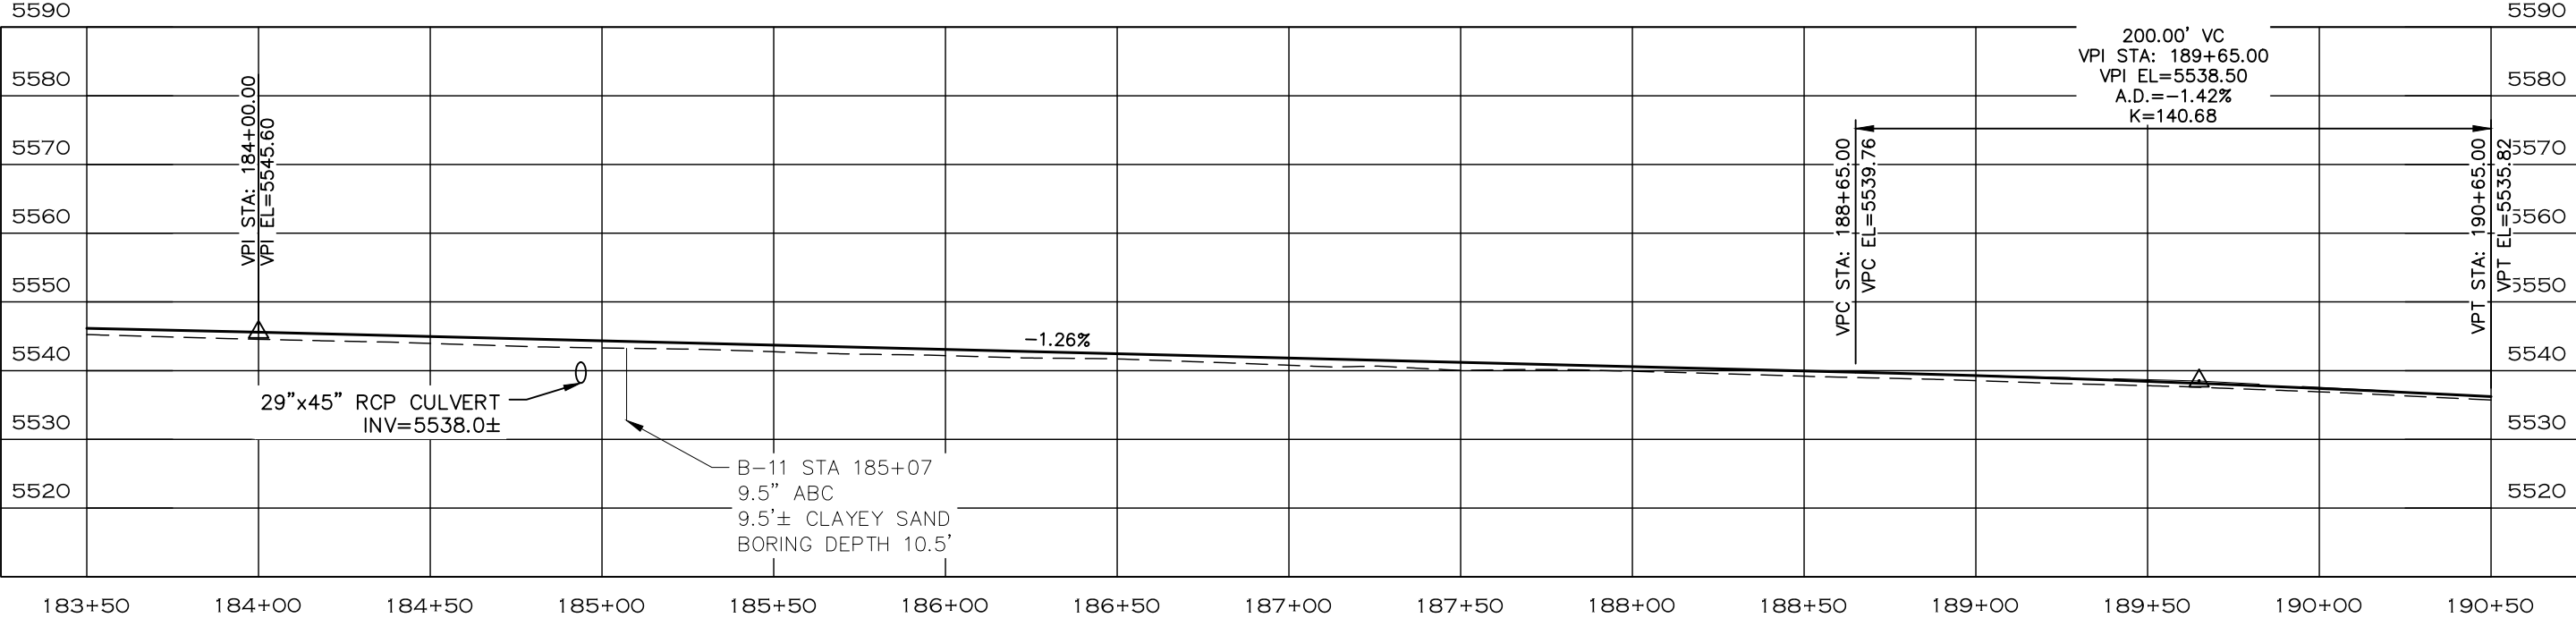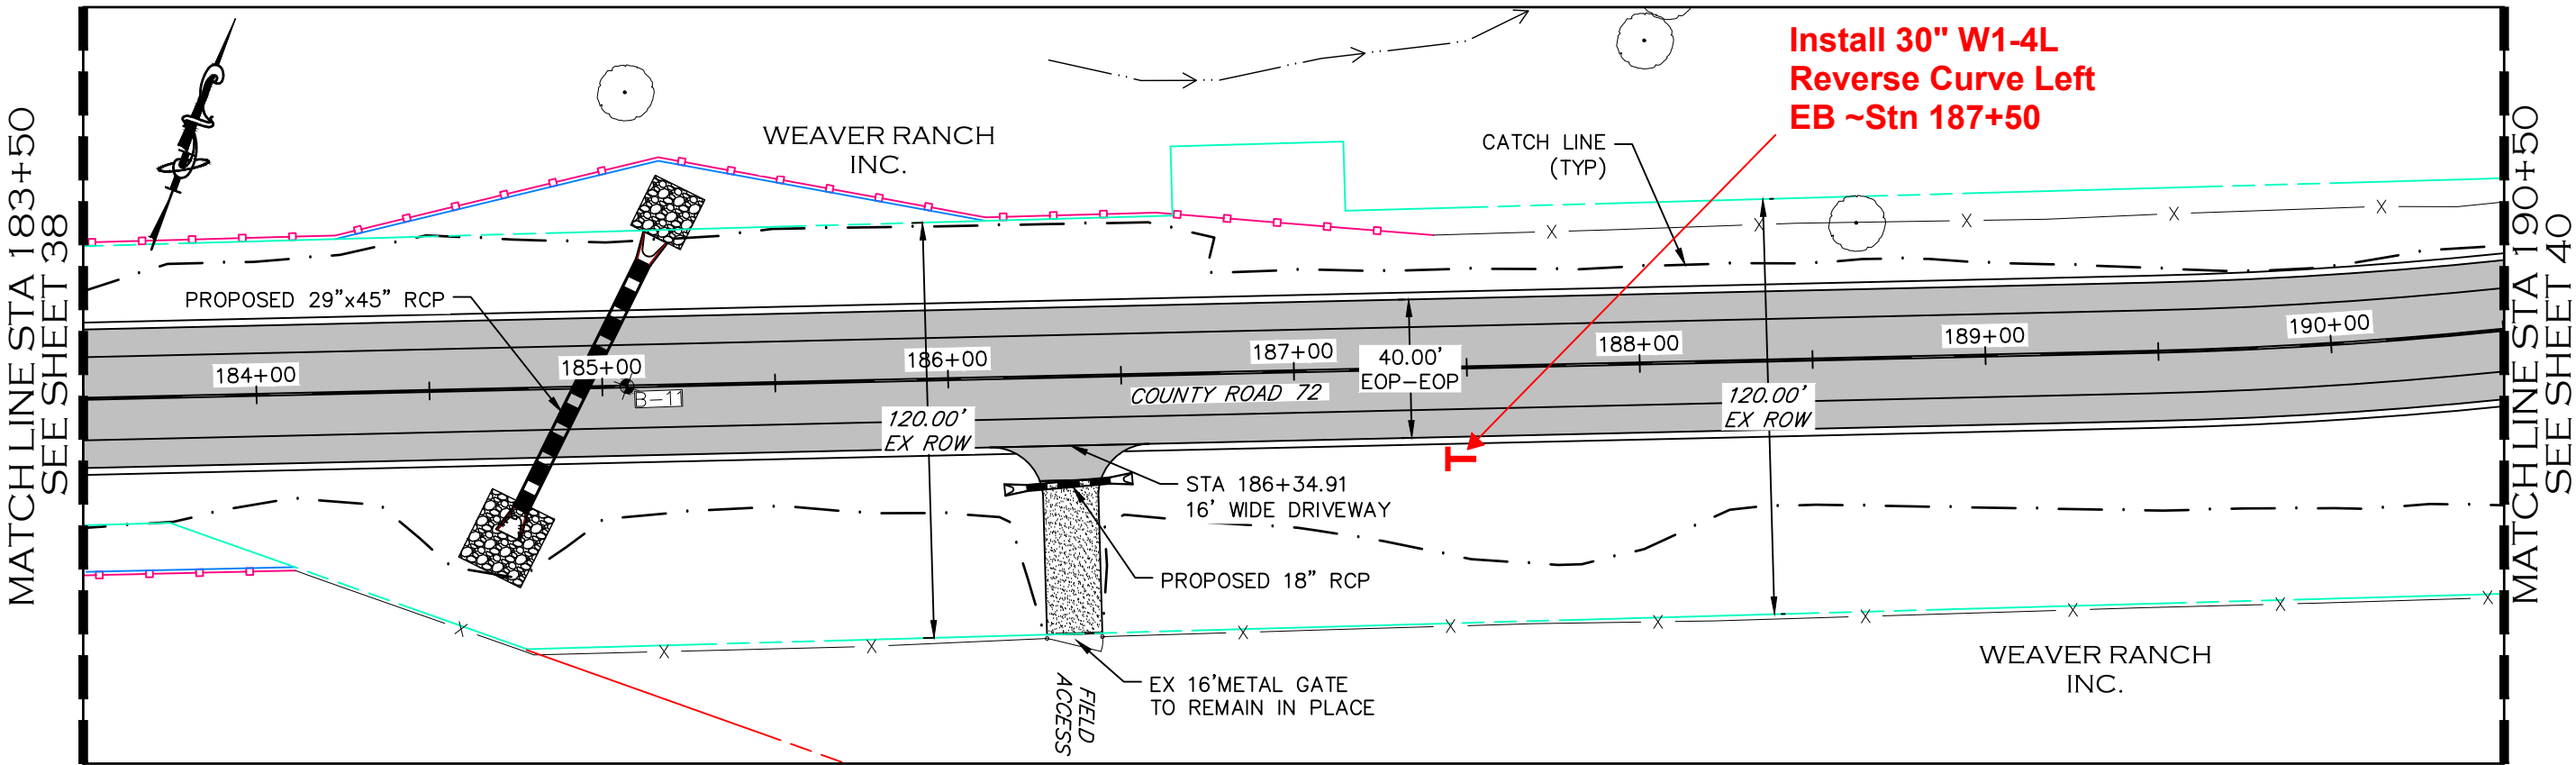




NOTE

1. ALL DRIVEWAY RADII ARE 15 FEET UNLESS OTHERWISE NOTED.
2. PROPOSED FENCE TO BE SET ON PROPOSED ROW. FENCES SHOWN 1' OFF PROPOSED ROW FOR GRAPHICAL PURPOSES.

- PROPOSED FENCE
- TEMPORARY CONSTRUCTION EASEMENT
- PROPOSED RIGHT-OF-WAY
- EXISTING RIGHT-OF-WAY
- EXISTING PROPERTY LINE

CALL UTILITY NOTIFICATION
CENTER OF COLORADO
811
CALL 2-BUSINESS DAYS IN ADVANCE
BEFORE YOU DIG, GRADE, OR EXCAVATE
FOR THE MARKING OF UNDERGROUND
MEMBER UTILITIES.

COMPUTER INFORMATION		REVISIONS			ENGINEERING DEPARTMENT 200 WEST OAK, SUITE 3000 POST OFFICE BOX 1190 FORT COLLINS, COLORADO 80522-1190 (970)498-5700 (970)498-7986 FAX	AS CONSTRUCTED		PLAN & PROFILE STATION 183+50 TO 190+50	PROJECT NO. 335	
CREATION DATE:	07/13/20	☐ R-1				NO REVISIONS:			LARIMER COUNTY ROAD 72	
MODIFICATION DATE:	02/01/21	☐ R-2				REVISED:			SHEET NO. 39	
FILE LOCATION:	INTEREST PROJECTS\2019 PROJECTS\1421-094-00 LARIMER COUNTY ROAD 72\DRAWINGS\ENGINEERING PLANS	☐ R-3				VOID:				
FILE NAME:	1421-094-00 P&P.DWG	☐ R-4								
		☐ R-5								

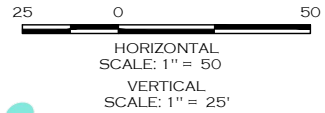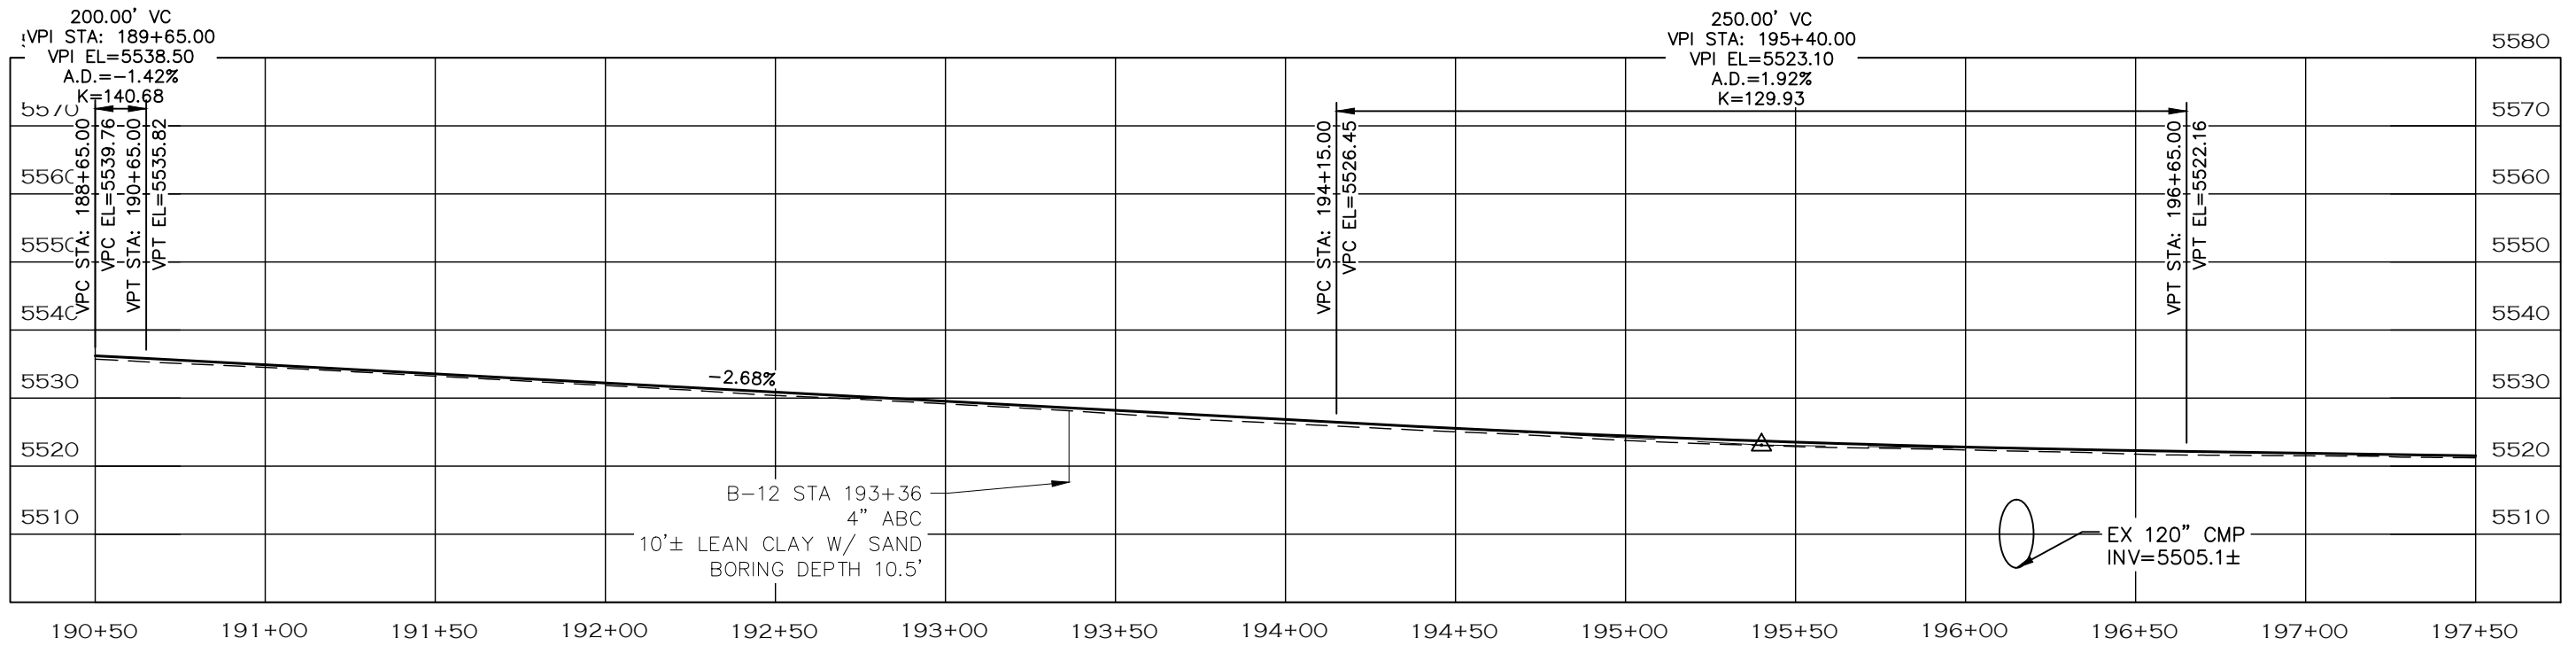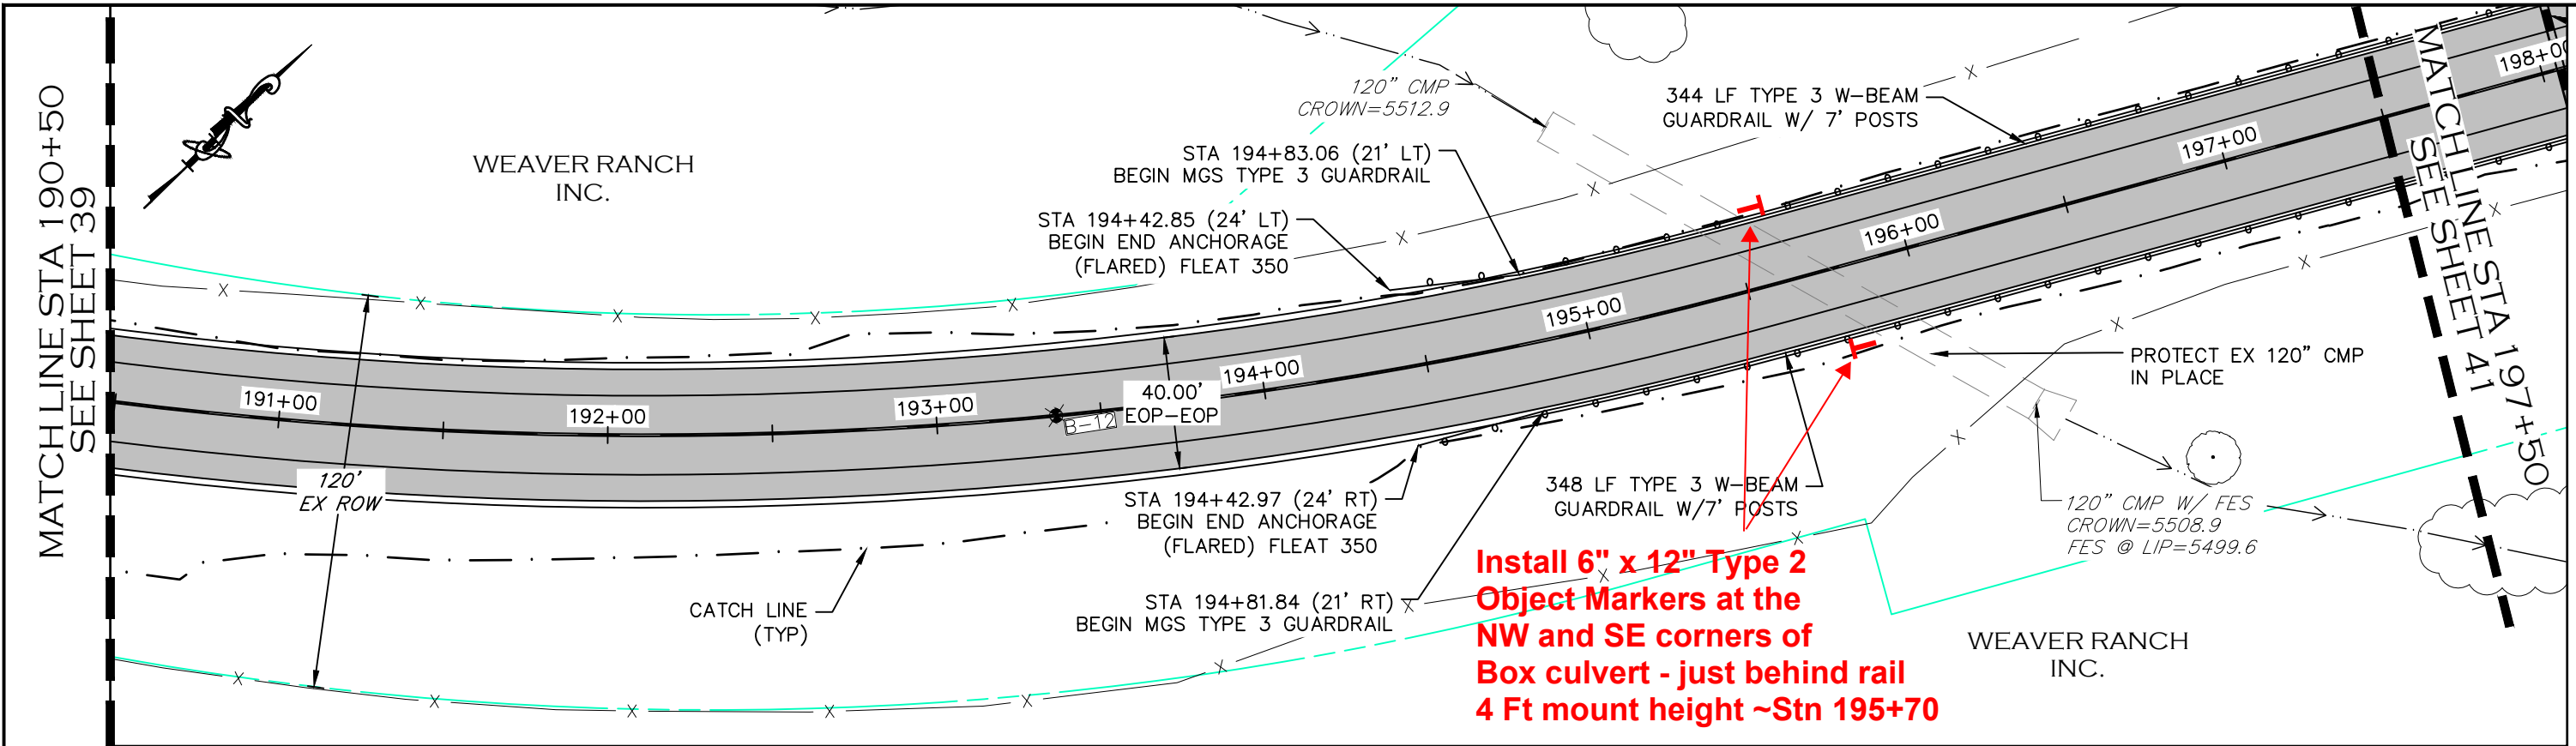




NOTE

1. ALL DRIVEWAY RADII ARE 15 FEET UNLESS OTHERWISE NOTED.
2. GUARDRAIL SHALL BE MIDWEST GUARDRAIL SYSTEM TYPE 3 W BEAM WITH GALVANIZED STEEL RAIL AND END SECTIONS. REFER TO CDOT M-606-1.
3. PROPOSED FENCE TO BE SET ON PROPOSED ROW. FENCES SHOWN 1' OFF PROPOSED ROW FOR GRAPHICAL PURPOSES.

- PROPOSED FENCE
- TEMPORARY CONSTRUCTION EASEMENT
- PROPOSED RIGHT-OF-WAY
- EXISTING RIGHT-OF-WAY
- EXISTING PROPERTY LINE

CALL UTILITY NOTIFICATION
CENTER OF COLORADO
811
CALL 2-BUSINESS DAYS IN ADVANCE
BEFORE YOU DIG, GRADE, OR EXCAVATE
FOR THE MARKING OF UNDERGROUND
MEMBER UTILITIES.

COMPUTER INFORMATION		REVISIONS			ENGINEERING DEPARTMENT 200 WEST OAK, SUITE 3000 POST OFFICE BOX 1190 FORT COLLINS, COLORADO 80522-1190 (970)498-5700 (970)498-7986 FAX	AS CONSTRUCTED		PLAN & PROFILE STATION 190+50 TO 197+50	PROJECT NO. 335	
CREATION DATE:	07/13/20	R-1				NO REVISIONS:			LARIMER COUNTY ROAD 72	
MODIFICATION DATE:	02/01/21	R-2				REVISED:			SHEET NO. 40	
FILE LOCATION:	INTEREST PROJECTS\2019 PROJECTS\1421-094-00 LARIMER COUNTY ROAD 72\DRAWINGS\ENGINEERING PLANS	R-3				VOID:				
FILE NAME:	1421-094-00 P&P.DWG	R-4								
		R-5								

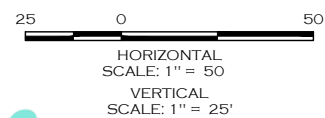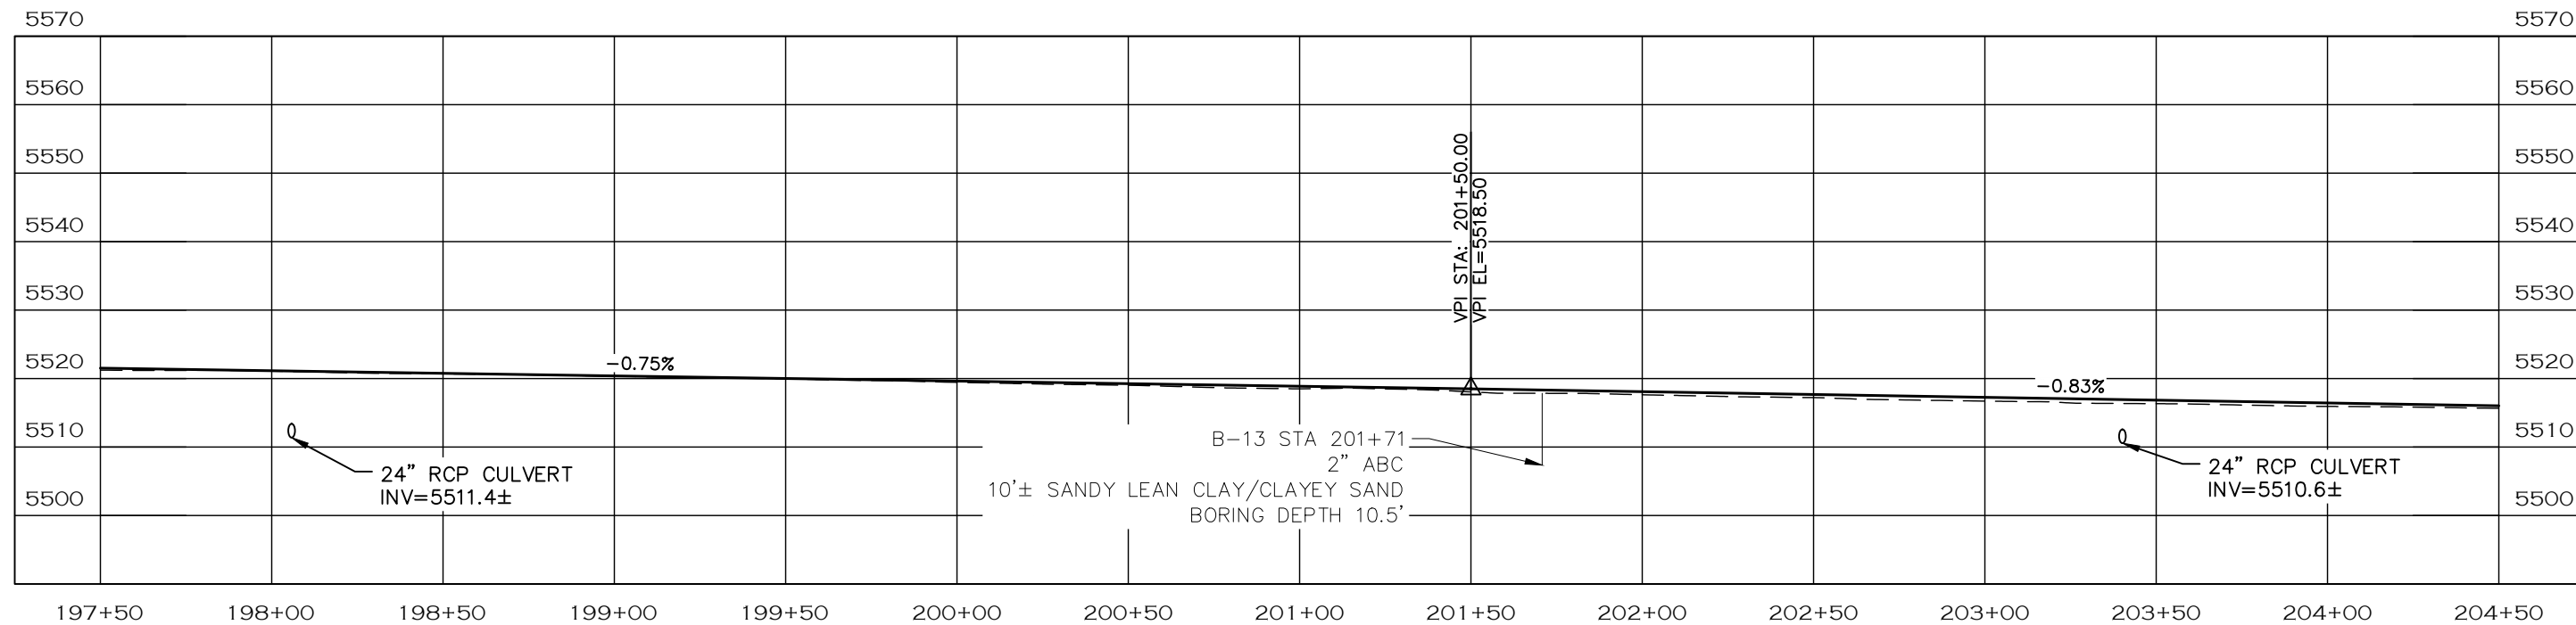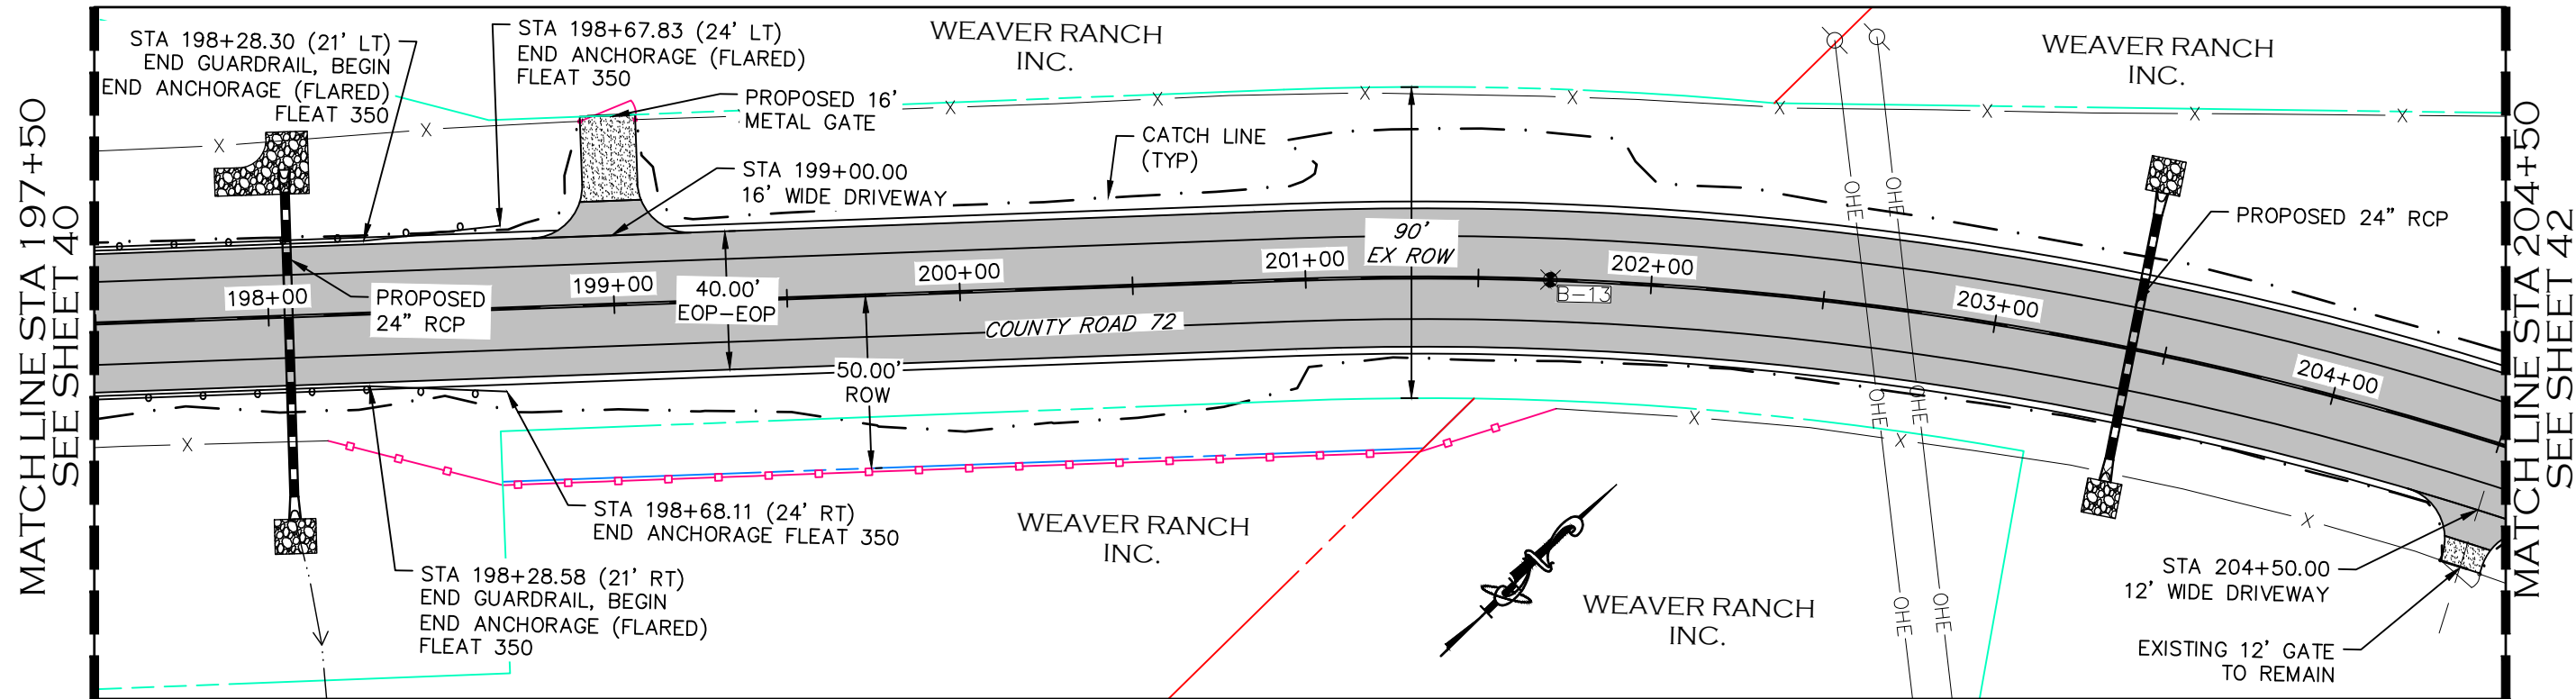

NOTE

- ALL DRIVEWAY RADII ARE 15 FEET UNLESS OTHERWISE NOTED.
- GUARDRAIL SHALL BE MIDWEST GUARDRAIL SYSTEM TYPE 3 W BEAM WITH GALVANIZED STEEL RAIL AND END SECTIONS. REFER TO CDOT M-606-1.
- PROPOSED FENCE TO BE SET ON PROPOSED ROW. FENCES SHOWN 1' OFF PROPOSED ROW FOR GRAPHICAL PURPOSES.

- PROPOSED FENCE
- TEMPORARY CONSTRUCTION EASEMENT
- PROPOSED RIGHT-OF-WAY
- EXISTING RIGHT-OF-WAY
- EXISTING PROPERTY LINE

CALL UTILITY NOTIFICATION
CENTER OF COLORADO
811
CALL 2-BUSINESS DAYS IN ADVANCE
BEFORE YOU DIG, GRADE, OR EXCAVATE
FOR THE MARKING OF UNDERGROUND
MEMBER UTILITIES.

COMPUTER INFORMATION

CREATION DATE: 07/13/20
MODIFICATION DATE: 02/01/21
FILE LOCATION: I:\PROJECTS\2019 PROJECTS\1421-094-00 (LARIMER COUNTY ROAD 72)\DRAWINGS\ENGINEERING PLANS
FILE NAME: 1421-094-00 P&P.DWG

REVISIONS

R-1		
R-2		
R-3		
R-4		
R-5		



ENGINEERING DEPARTMENT

200 WEST OAK, SUITE 3000
POST OFFICE BOX 1190
FORT COLLINS, COLORADO 80522-1190
(970)498-5700
(970)498-7986 FAX

AS CONSTRUCTED


NO REVISIONS:
REVISED:
VOID:

PLAN & PROFILE STATION 197+50 TO 204+50



PROJECT NO. 335

LARIMER COUNTY ROAD 72

SHEET NO. 41

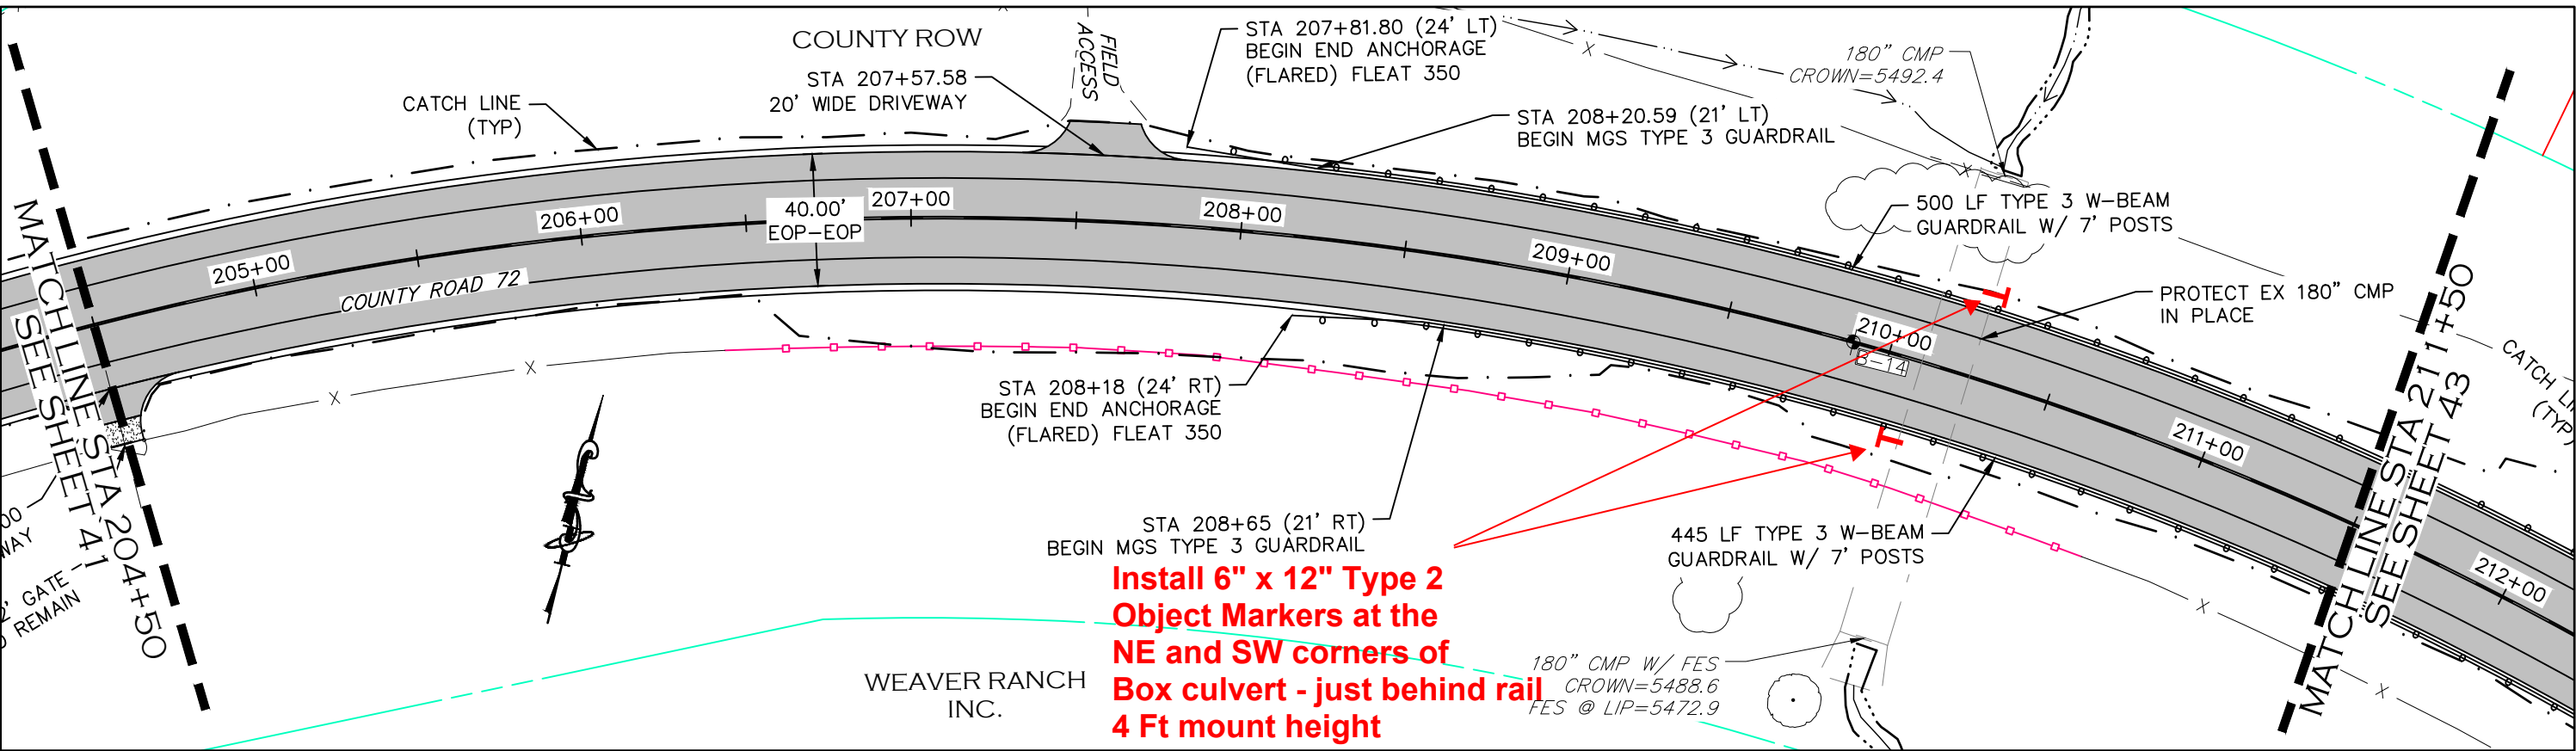

**Install 6" x 12" Type 2
Object Markers at the
NE and SW corners of
Box culvert - just behind rail
4 Ft mount height**

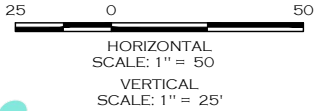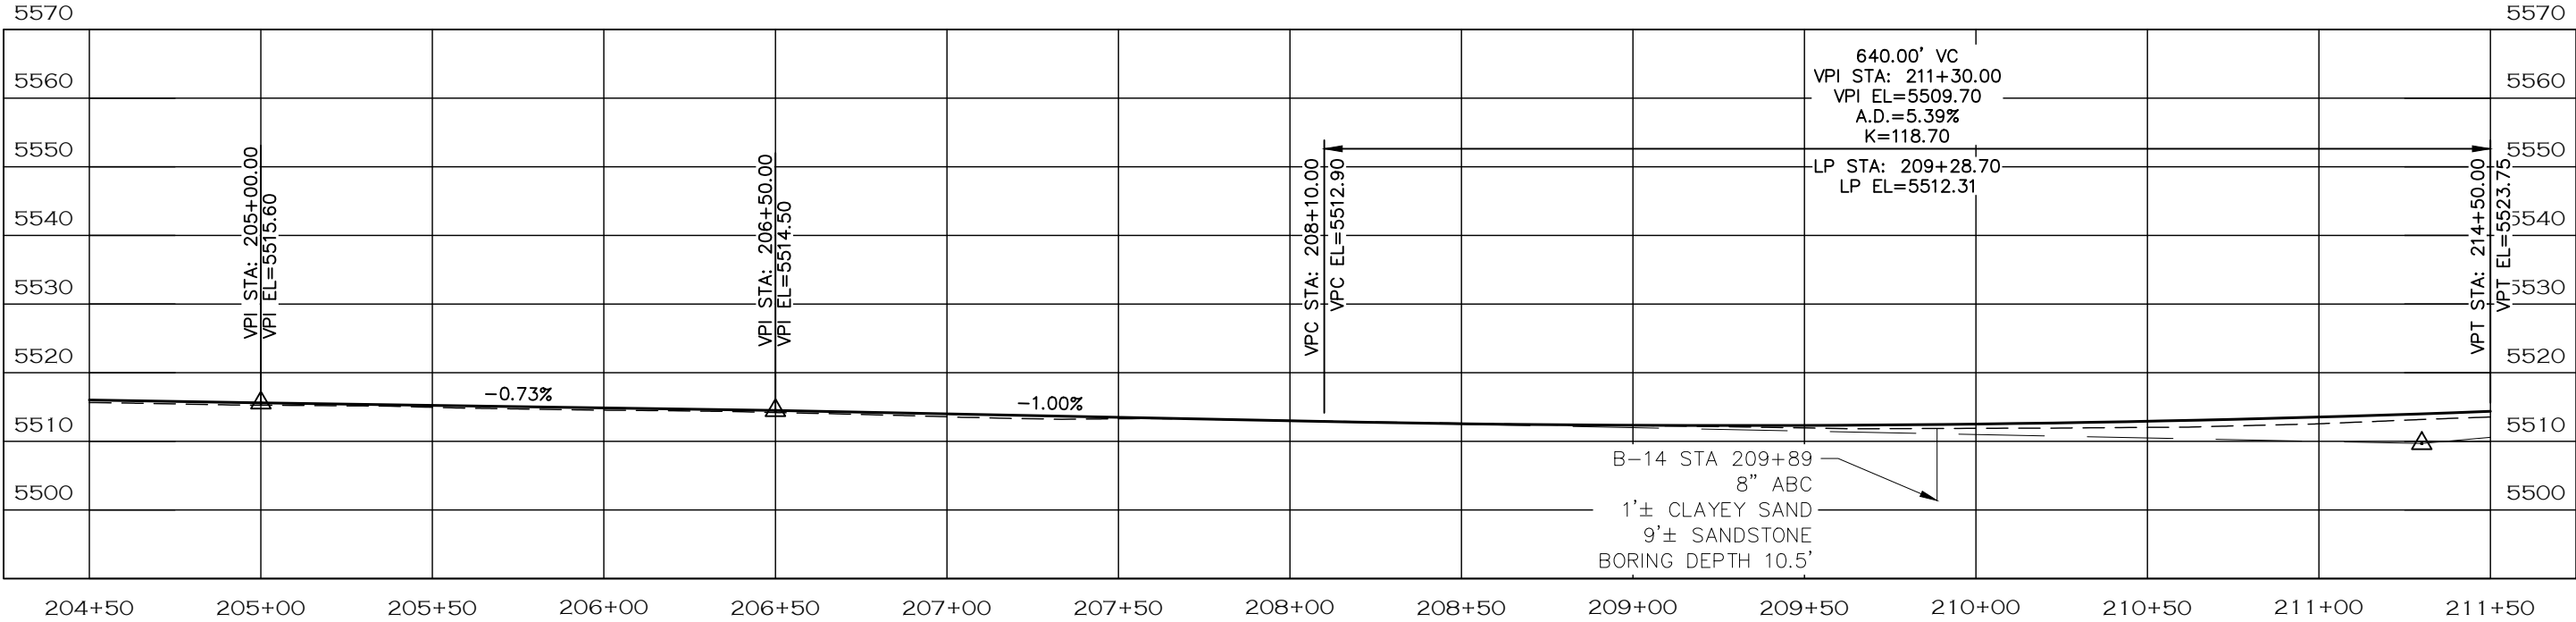




NOTE

1. ALL DRIVEWAY RADII ARE 15 FEET UNLESS OTHERWISE NOTED.
2. GUARDRAIL SHALL BE MIDWEST GUARDRAIL SYSTEM TYPE 3 W BEAM WITH GALVANIZED STEEL RAIL AND END SECTIONS. REFER TO CDOT M-606-1.
3. PROPOSED FENCE TO BE SET ON PROPOSED ROW. FENCES SHOWN 1' OFF PROPOSED ROW FOR GRAPHICAL PURPOSES.

- PROPOSED FENCE
- TEMPORARY CONSTRUCTION EASEMENT
- PROPOSED RIGHT-OF-WAY
- EXISTING RIGHT-OF-WAY
- EXISTING PROPERTY LINE

CALL UTILITY NOTIFICATION
CENTER OF COLORADO
811
CALL 2-BUSINESS DAYS IN ADVANCE
BEFORE YOU DIG, GRADE, OR EXCAVATE
FOR THE MARKING OF UNDERGROUND
MEMBER UTILITIES.

COMPUTER INFORMATION		REVISIONS			ENGINEERING DEPARTMENT 200 WEST OAK, SUITE 3000 POST OFFICE BOX 1190 FORT COLLINS, COLORADO 80522-1190 (970)498-5700 (970)498-7986 FAX	AS CONSTRUCTED		PLAN & PROFILE STATION 204+50 TO 211+50	PROJECT NO. 335	
CREATION DATE:	07/13/20	(R-1)				NO REVISIONS:			LARIMER COUNTY ROAD 72	
MODIFICATION DATE:	02/01/21	(R-2)				REVISED:			SHEET NO. 42	
FILE LOCATION:	INTEREST PROJECTS\2019 PROJECTS\1421-094-00 (LARIMER COUNTY ROAD 72)\DRAWINGS\ENGINEERING PLANS	(R-3)				VOID:				
FILE NAME:	1421-094-00 P&P.DWG	(R-4)								
		(R-5)								

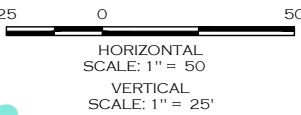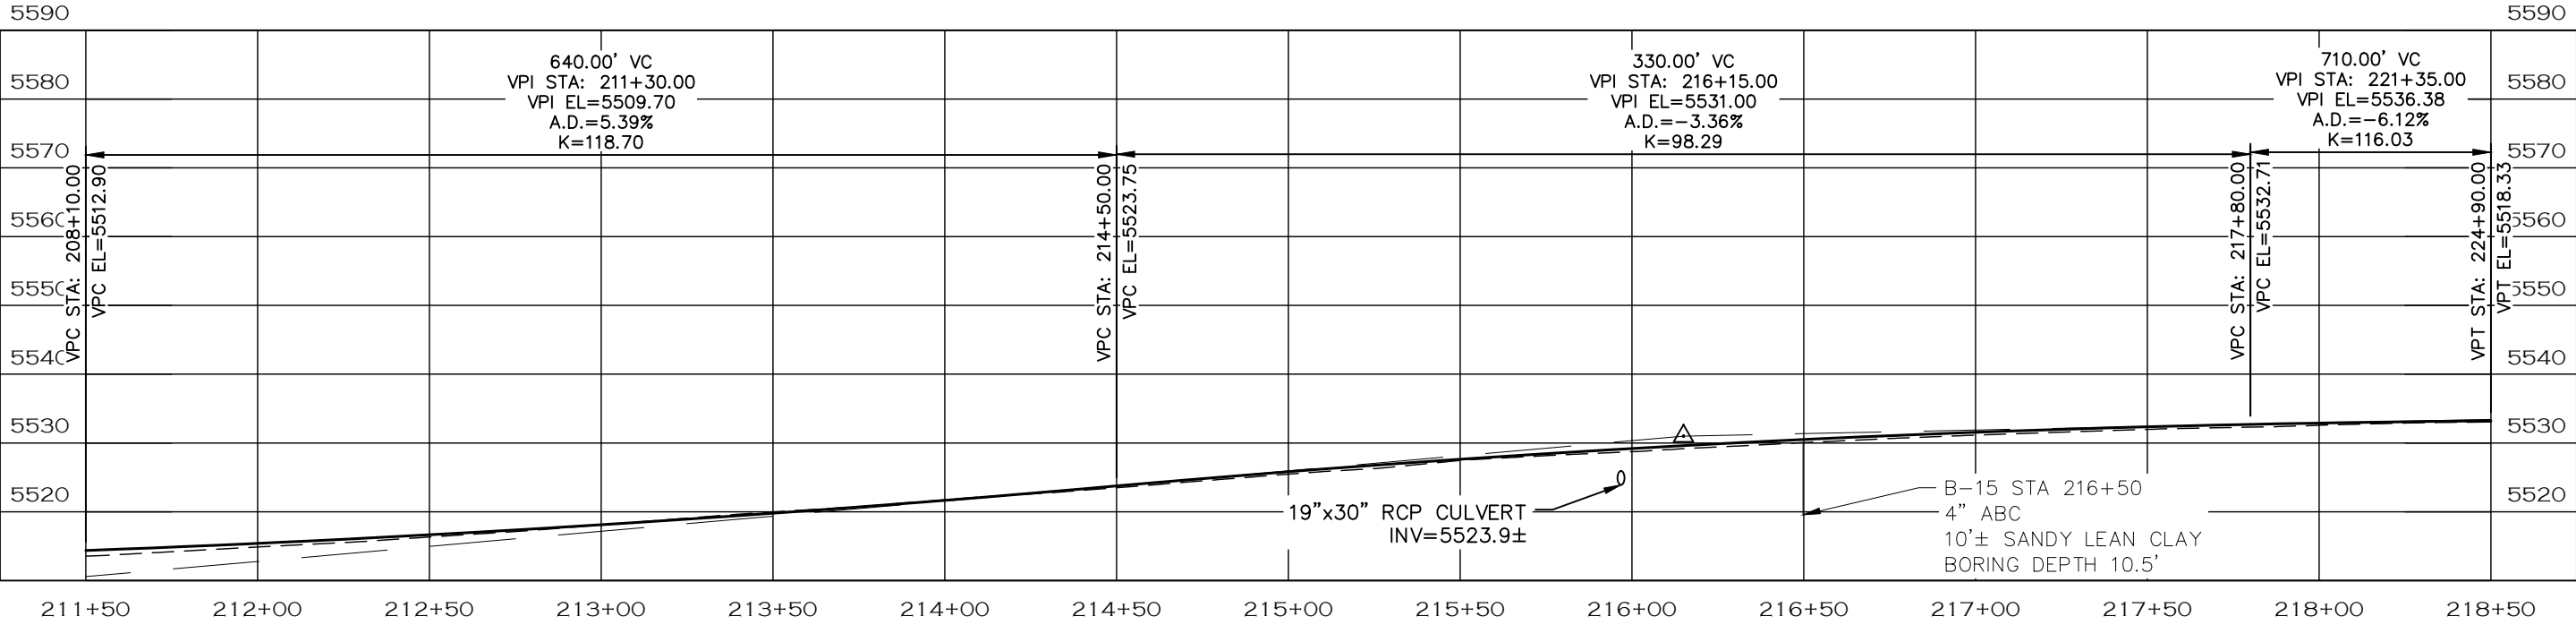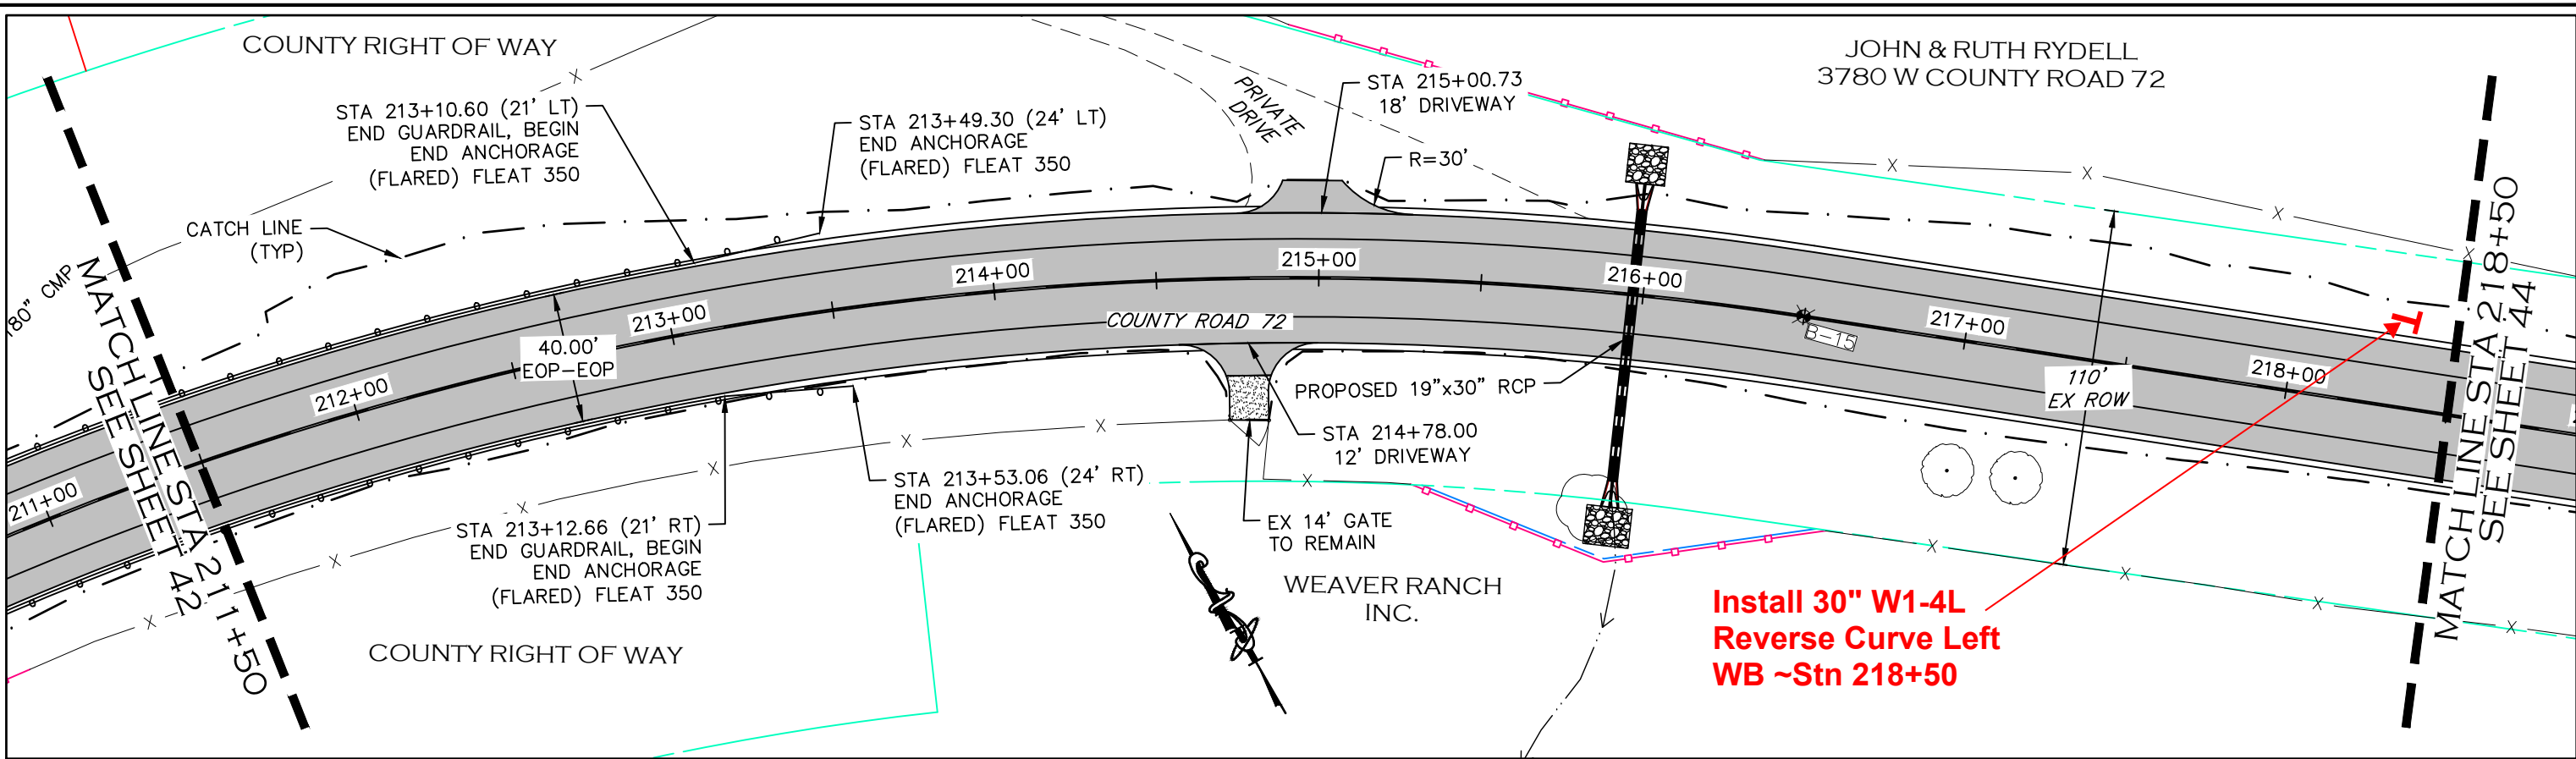




NOTE

1. ALL DRIVEWAY RADII ARE 15 FEET UNLESS OTHERWISE NOTED.
2. GUARDRAIL SHALL BE MIDWEST GUARDRAIL SYSTEM TYPE 3 W BEAM WITH GALVANIZED STEEL RAIL AND END SECTIONS. REFER TO CDOT M-606-1.
3. PROPOSED FENCE TO BE SET ON PROPOSED ROW. FENCES SHOWN 1' OFF PROPOSED ROW FOR GRAPHICAL PURPOSES.

- PROPOSED FENCE
- TEMPORARY CONSTRUCTION EASEMENT
- PROPOSED RIGHT-OF-WAY
- EXISTING RIGHT-OF-WAY
- EXISTING PROPERTY LINE

CALL UTILITY NOTIFICATION
CENTER OF COLORADO
811
CALL 2-BUSINESS DAYS IN ADVANCE
BEFORE YOU DIG, GRADE, OR EXCAVATE
FOR THE MARKING OF UNDERGROUND
MEMBER UTILITIES.

COMPUTER INFORMATION		REVISIONS			ENGINEERING DEPARTMENT 200 WEST OAK, SUITE 3000 POST OFFICE BOX 1190 FORT COLLINS, COLORADO 80522-1190 (970)498-5700 (970)498-7986 FAX	AS CONSTRUCTED		PLAN & PROFILE STATION 211+50 TO 218+50	PROJECT NO. 335	
CREATION DATE:	07/13/20	☐ R-1				NO REVISIONS:			LARIMER COUNTY ROAD 72	
MODIFICATION DATE:	02/01/21	☐ R-2				REVISED:			SHEET NO. 43	
FILE LOCATION:	INTEREST PROJECTS\2019 PROJECTS\1421-094-00 (LARIMER COUNTY ROAD 72)\DRAWINGS\ENGINEERING PLANS	☐ R-3				VOID:				
FILE NAME:	1421-094-00 P&P.DWG	☐ R-4								
		☐ R-5								

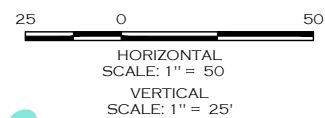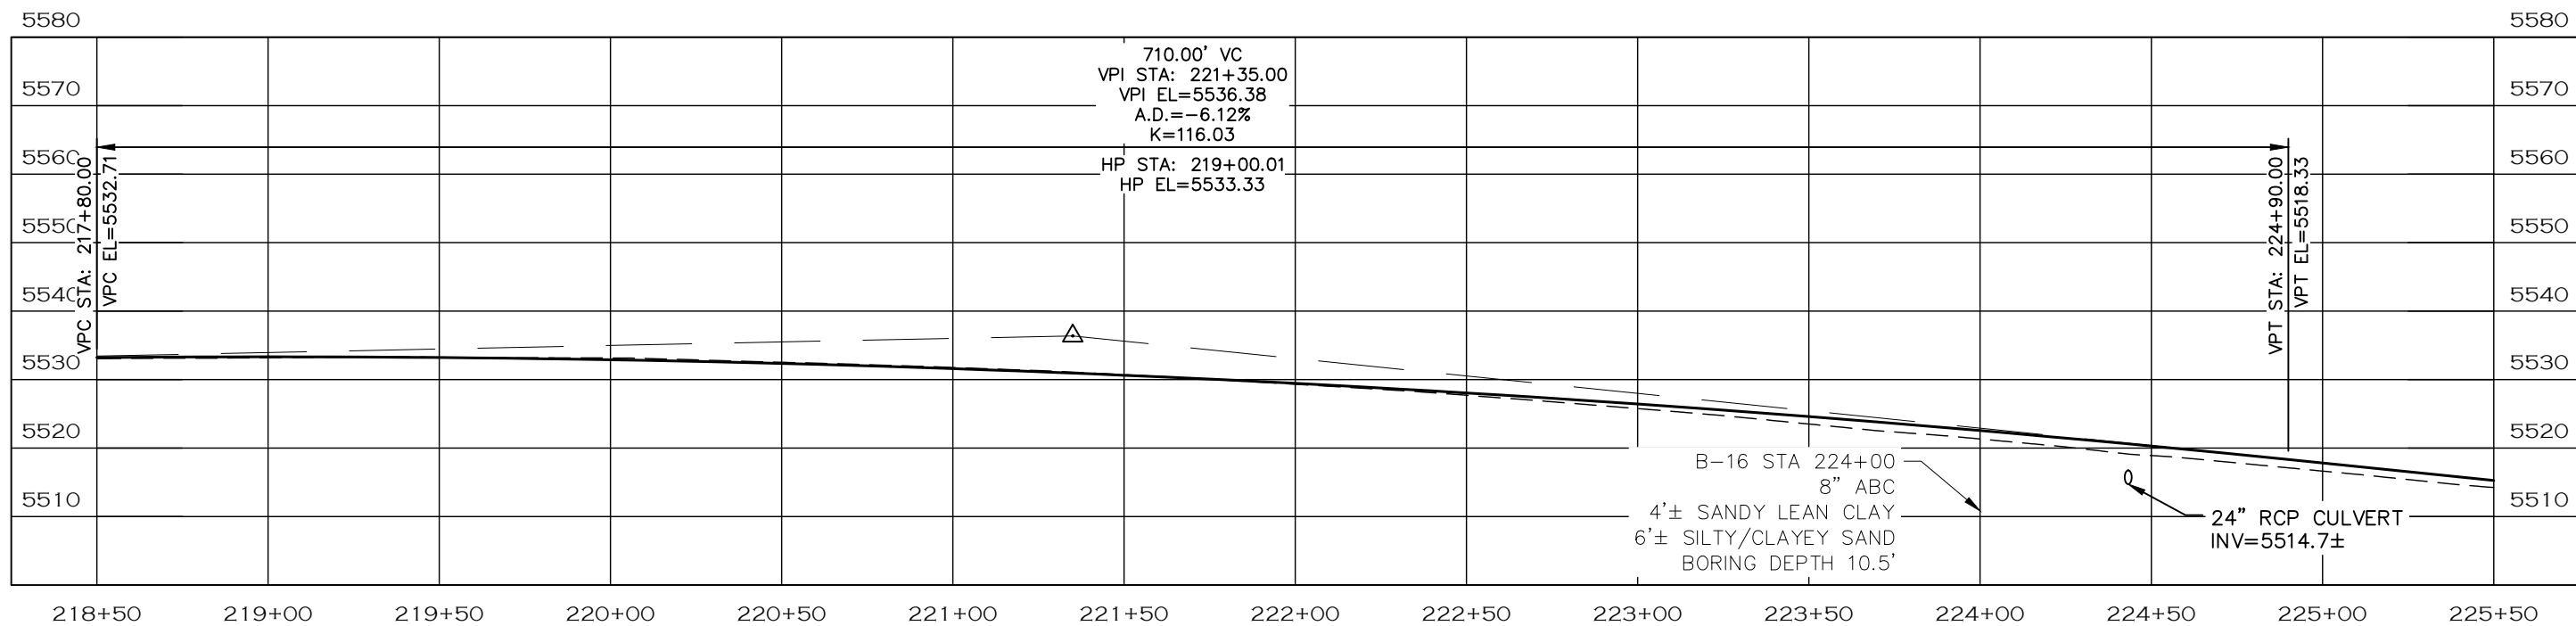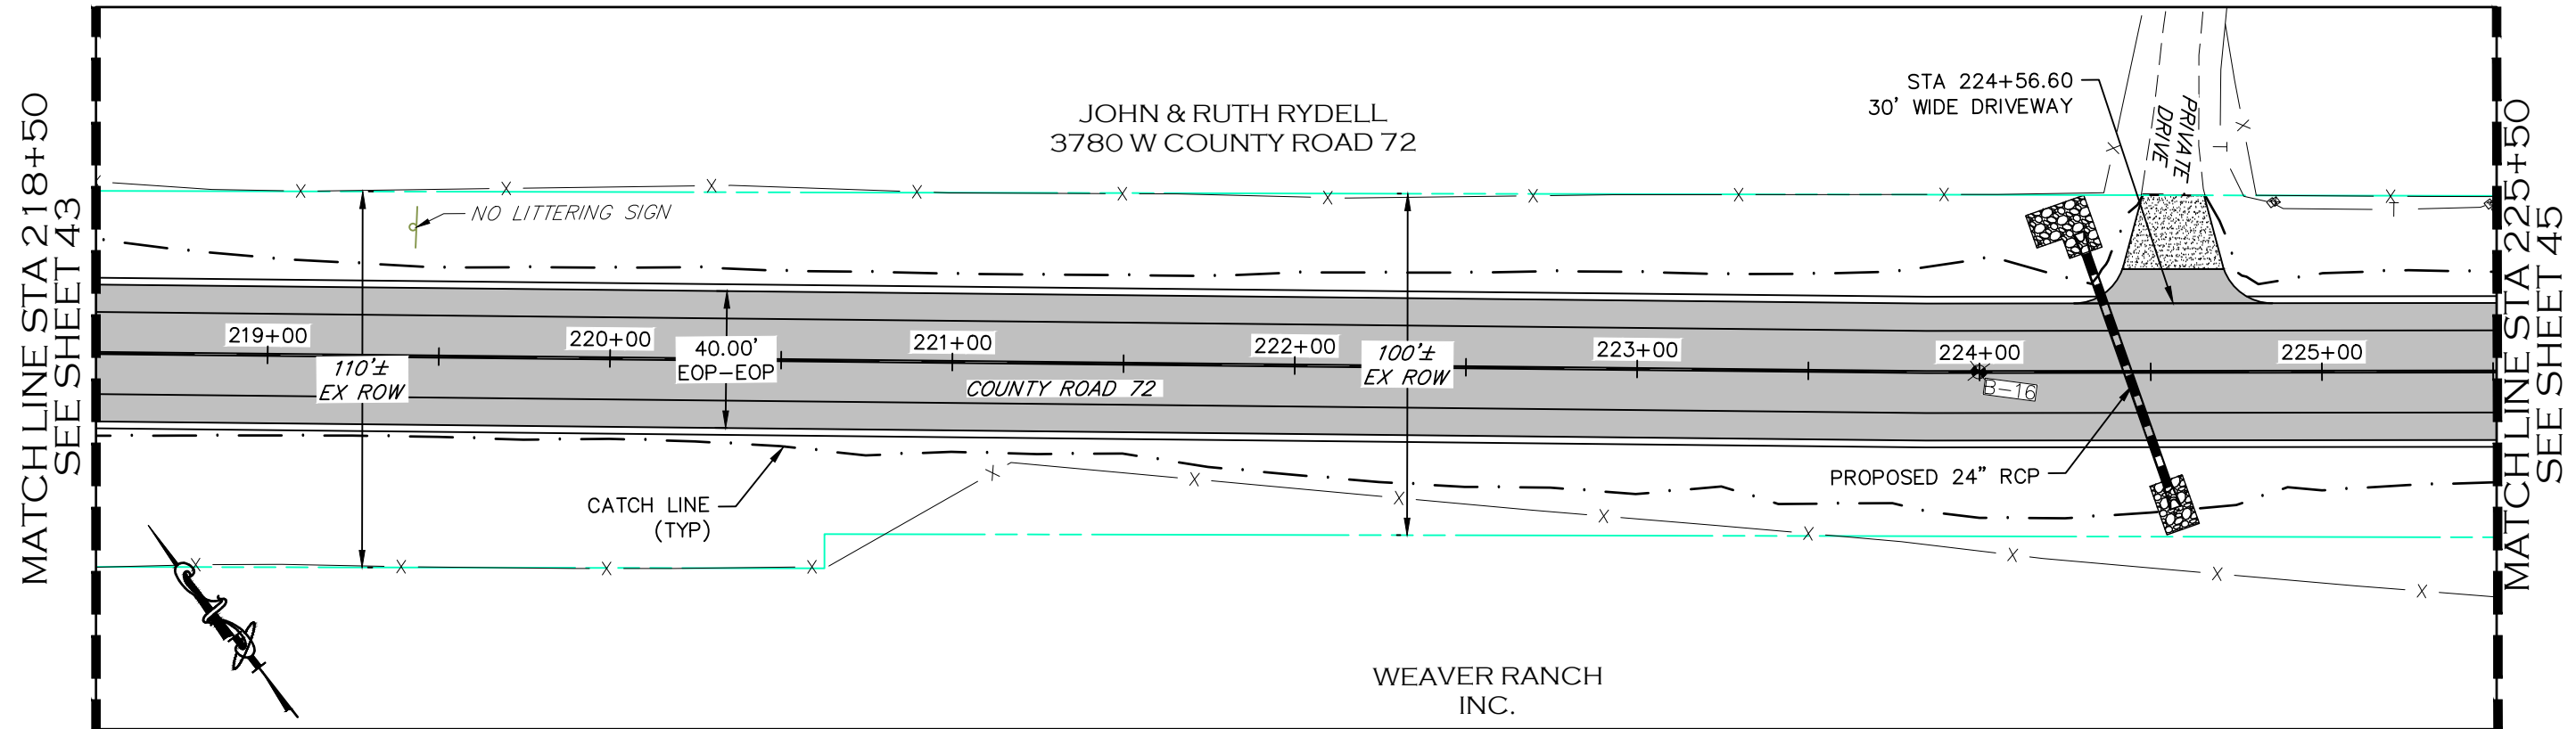




NOTE

1. ALL DRIVEWAY RADII ARE 15 FEET UNLESS OTHERWISE NOTED.
2. PROPOSED FENCE TO BE SET ON PROPOSED ROW. FENCES SHOWN 1' OFF PROPOSED ROW FOR GRAPHICAL PURPOSES.

- PROPOSED FENCE
- TEMPORARY CONSTRUCTION EASEMENT
- PROPOSED RIGHT-OF-WAY
- EXISTING RIGHT-OF-WAY
- EXISTING PROPERTY LINE

CALL UTILITY NOTIFICATION
CENTER OF COLORADO
811
CALL 2-BUSINESS DAYS IN ADVANCE
BEFORE YOU DIG, GRADE, OR EXCAVATE
FOR THE MARKING OF UNDERGROUND
MEMBER UTILITIES.

COMPUTER INFORMATION		REVISIONS			ENGINEERING DEPARTMENT 200 WEST OAK, SUITE 3000 POST OFFICE BOX 1190 FORT COLLINS, COLORADO 80522-1190 (970)498-5700 (970)498-7986 FAX	AS CONSTRUCTED		PLAN & PROFILE STATION 218+50 TO 225+50	PROJECT NO. 335	
CREATION DATE:	07/13/20	☐ R-1				NO REVISIONS:			LARIMER COUNTY ROAD 72	
MODIFICATION DATE:	02/01/21	☐ R-2				REVISED:			SHEET NO. 44	
FILE LOCATION:	INTEREST PROJECTS\2019 PROJECTS\1421-094-00 (LARIMER COUNTY ROAD 72)\DRAWINGS\ENGINEERING PLANS	☐ R-3				VOID:				
FILE NAME:	1421-094-00 P&P.DWG	☐ R-4								
		☐ R-5								

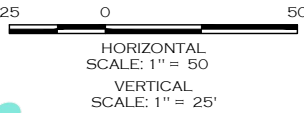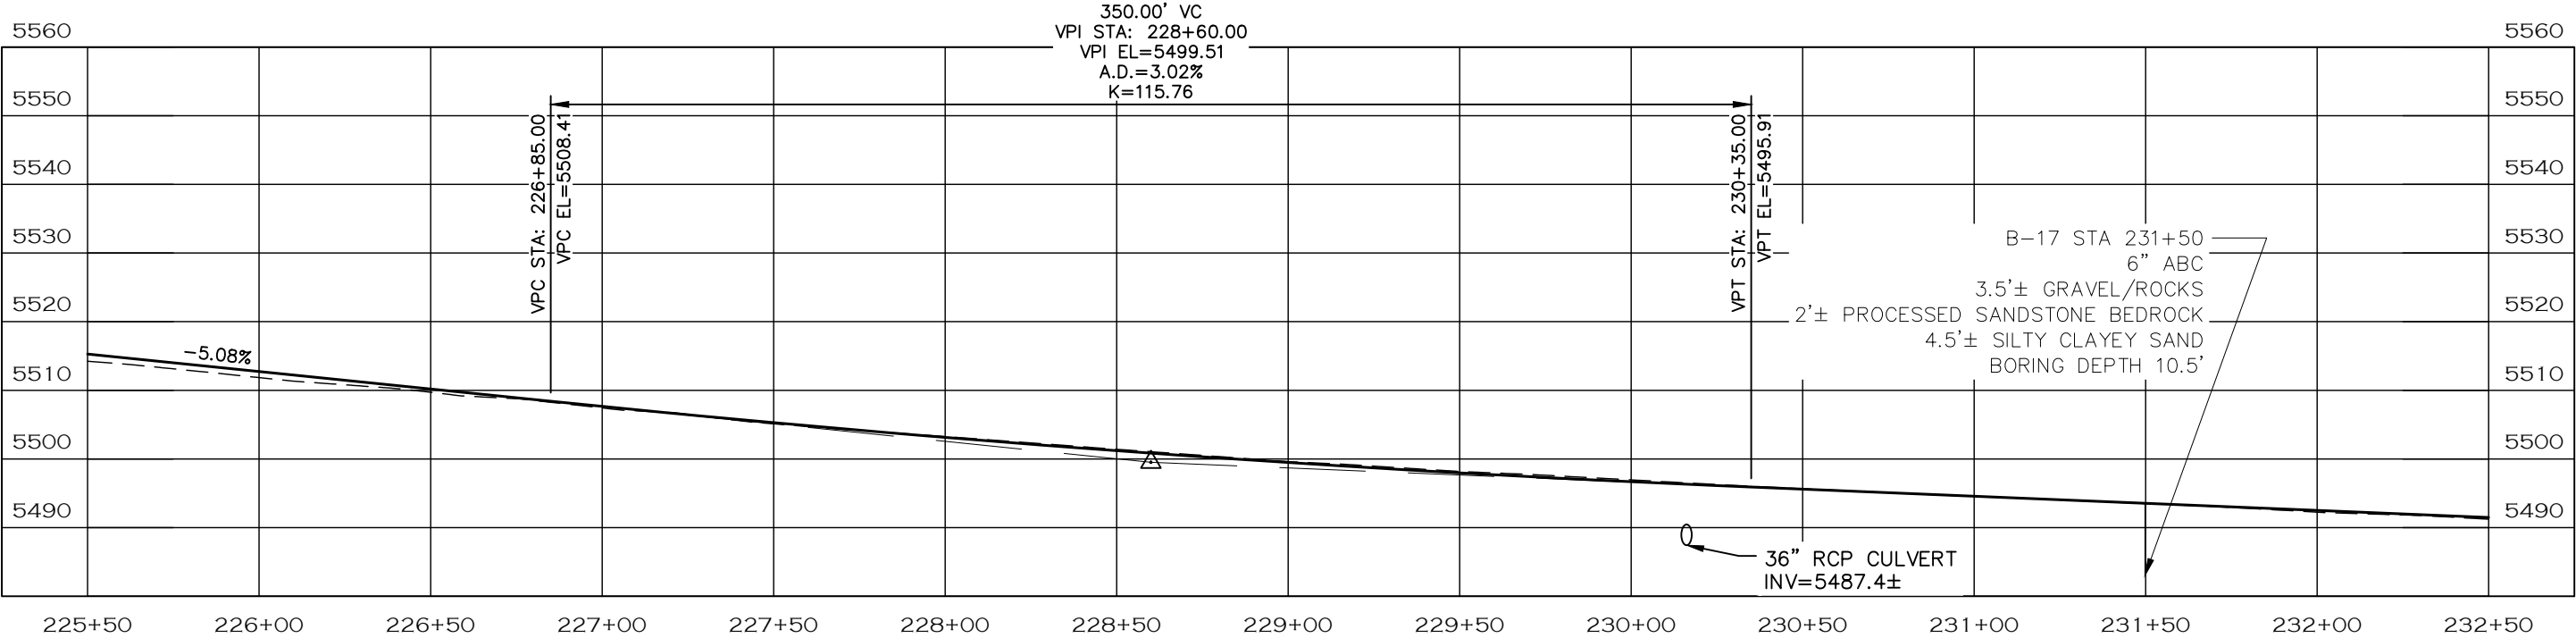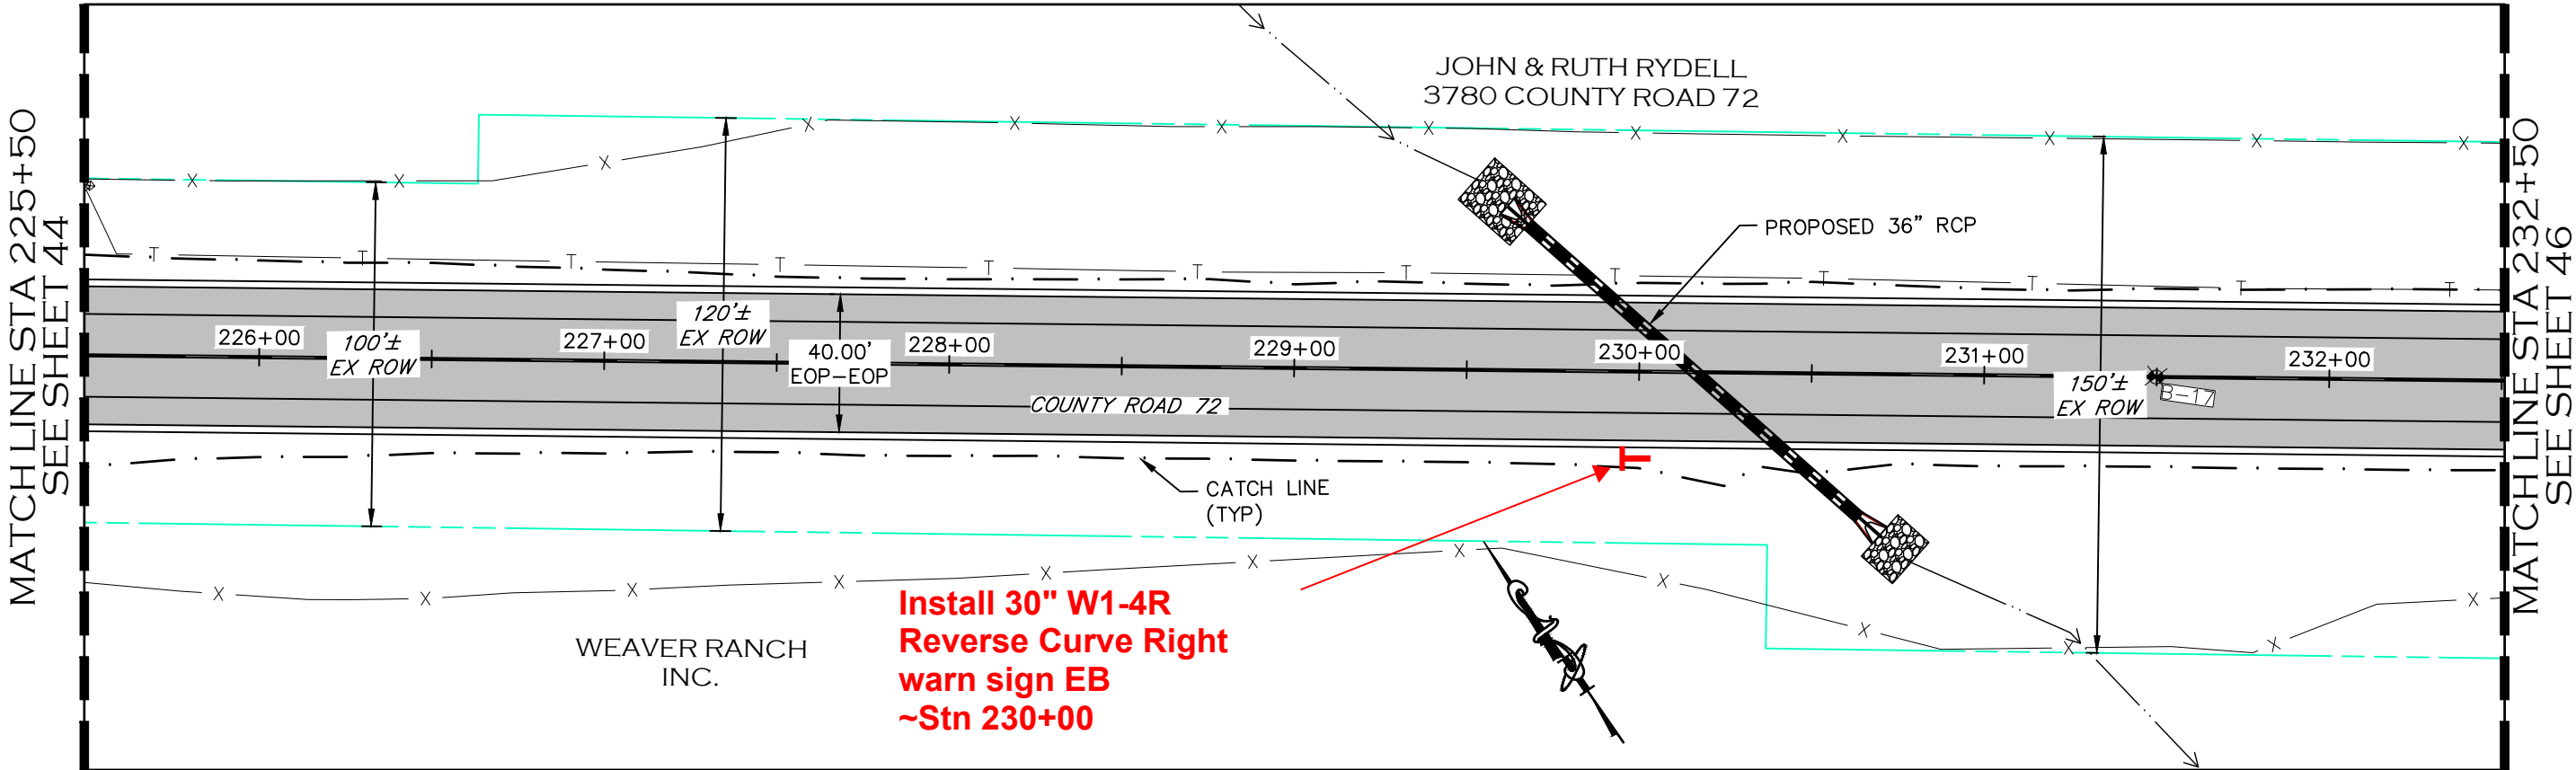

NOTE




- 1. ALL DRIVEWAY RADII ARE 15 FEET UNLESS OTHERWISE NOTED.
- 2. PROPOSED FENCE TO BE SET ON PROPOSED ROW. FENCES SHOWN 1' OFF PROPOSED ROW FOR GRAPHICAL PURPOSES.

- PROPOSED FENCE
- TEMPORARY CONSTRUCTION EASEMENT
- PROPOSED RIGHT-OF-WAY
- EXISTING RIGHT-OF-WAY
- EXISTING PROPERTY LINE

CALL UTILITY NOTIFICATION
CENTER OF COLORADO
811
CALL 2-BUSINESS DAYS IN ADVANCE
BEFORE YOU DIG, GRADE, OR EXCAVATE
FOR THE MARKING OF UNDERGROUND
MEMBER UTILITIES.

COMPUTER INFORMATION		REVISIONS			ENGINEERING DEPARTMENT 200 WEST OAK, SUITE 3000 POST OFFICE BOX 1190 FORT COLLINS, COLORADO 80522-1190 (970)498-5700 (970)498-7986 FAX	AS CONSTRUCTED		PROJECT NO. 335		
CREATION DATE:	07/13/20	R-1				NO REVISIONS:		LARIMER COUNTY ROAD 72		
MODIFICATION DATE:	02/01/21	R-2				REVISED:		SHEET NO. 45		
FILE LOCATION:	INTEREST PROJECTS\2019 PROJECTS\1421-094-00 (LARIMER COUNTY ROAD 72)\DRAWINGS\ENGINEERING PLANS	R-3				VOID:				
FILE NAME:	1421-094-00 P&P.DWG	R-4								
		R-5								

PN 335 - Sign Plan

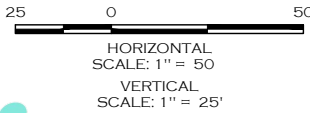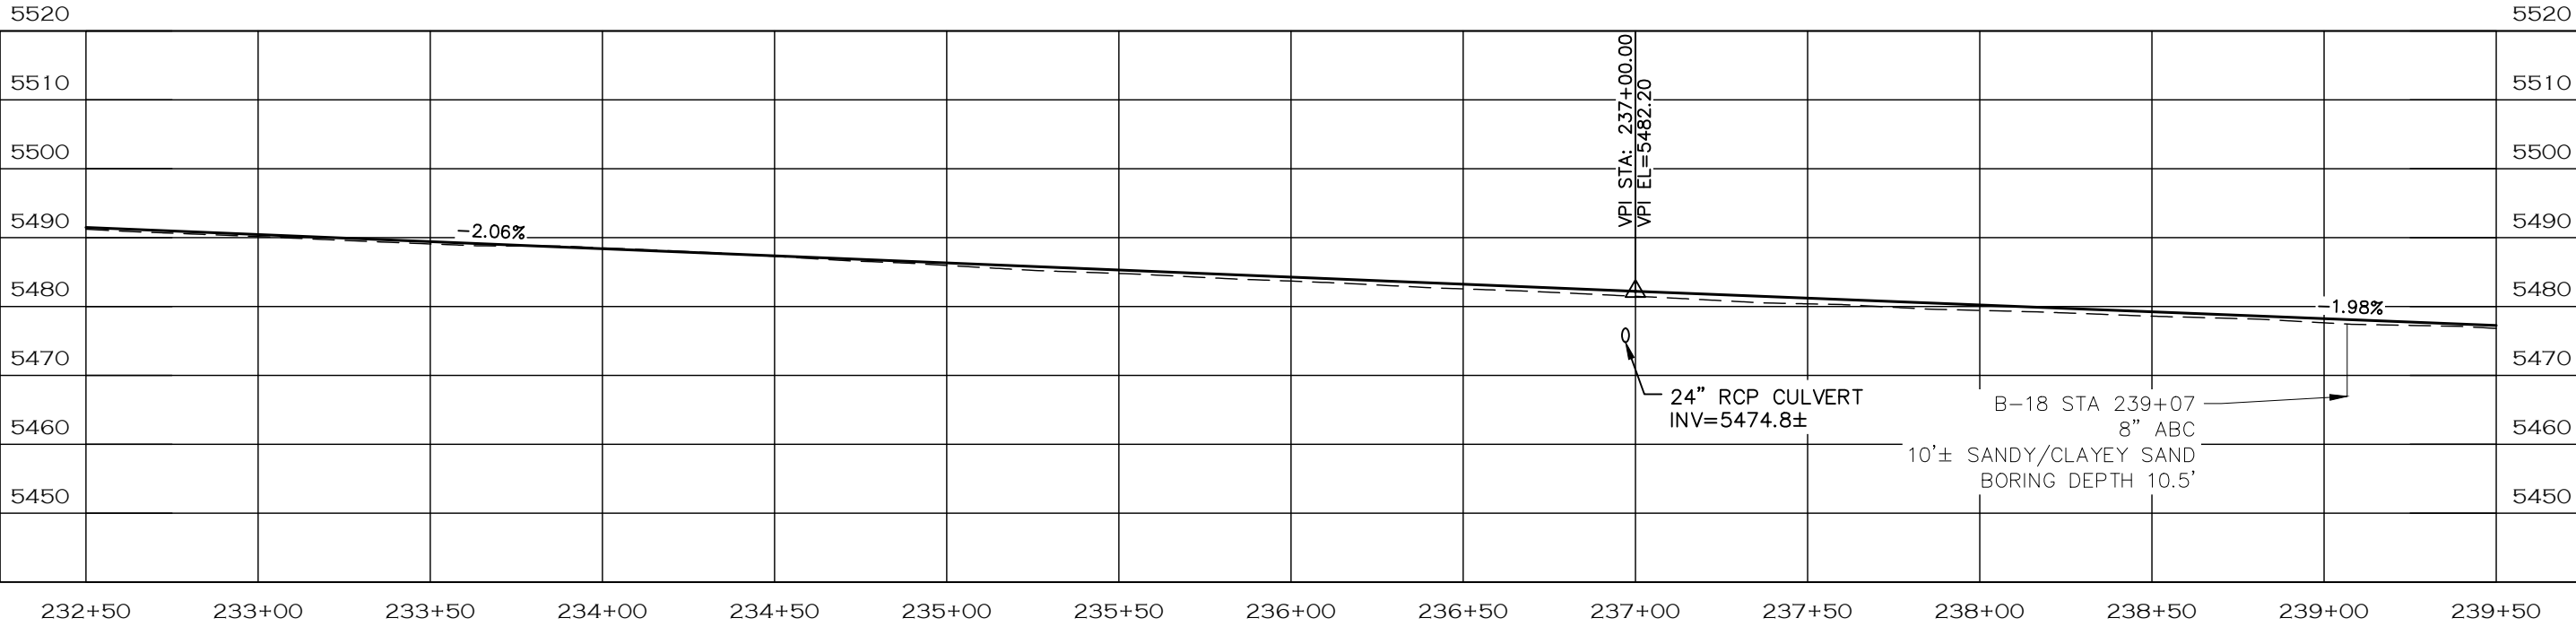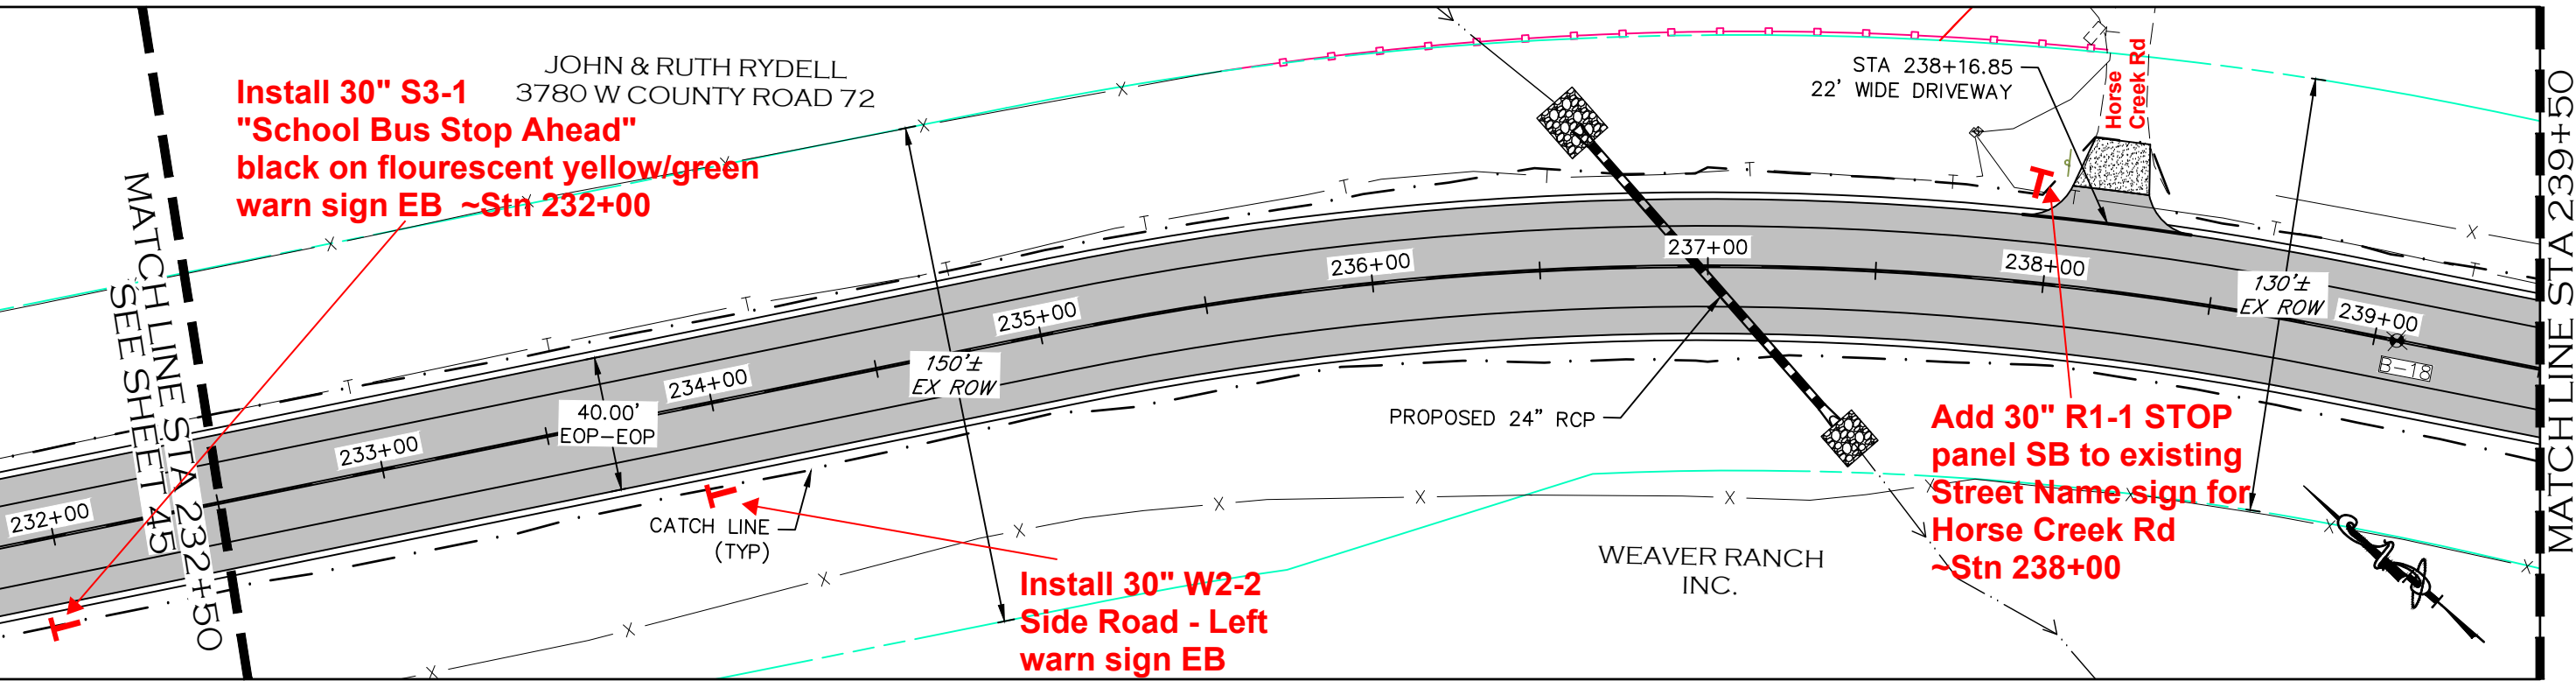




NOTE

1. ALL DRIVEWAY RADII ARE 15 FEET UNLESS OTHERWISE NOTED.
2. PROPOSED FENCE TO BE SET ON PROPOSED ROW. FENCES SHOWN 1' OFF PROPOSED ROW FOR GRAPHICAL PURPOSES.

- PROPOSED FENCE
- TEMPORARY CONSTRUCTION EASEMENT
- PROPOSED RIGHT-OF-WAY
- EXISTING RIGHT-OF-WAY
- EXISTING PROPERTY LINE

CALL UTILITY NOTIFICATION
CENTER OF COLORADO
811
CALL 2-BUSINESS DAYS IN ADVANCE
BEFORE YOU DIG, GRADE, OR EXCAVATE
FOR THE MARKING OF UNDERGROUND
MEMBER UTILITIES.

COMPUTER INFORMATION		REVISIONS			ENGINEERING DEPARTMENT 200 WEST OAK, SUITE 3000 POST OFFICE BOX 1190 FORT COLLINS, COLORADO 80522-1190 (970)498-5700 (970)498-7986 FAX	AS CONSTRUCTED		PLAN & PROFILE STATION 232+50 TO 239+50	PROJECT NO. 335	
CREATION DATE:	07/13/20	☒ R-1				NO REVISIONS:			LARIMER COUNTY ROAD 72	
MODIFICATION DATE:	02/01/21	☒ R-2				REVISED:			SHEET NO. 46	
FILE LOCATION:	INTEREST PROJECTS\2019 PROJECTS\1421-094-00 (LARIMER COUNTY ROAD 72)\DRAWINGS\ENGINEERING PLANS	☒ R-3				VOID:				
FILE NAME:	1421-094-00 P&P.DWG	☒ R-4								
		☒ R-5								

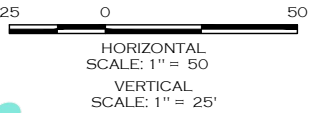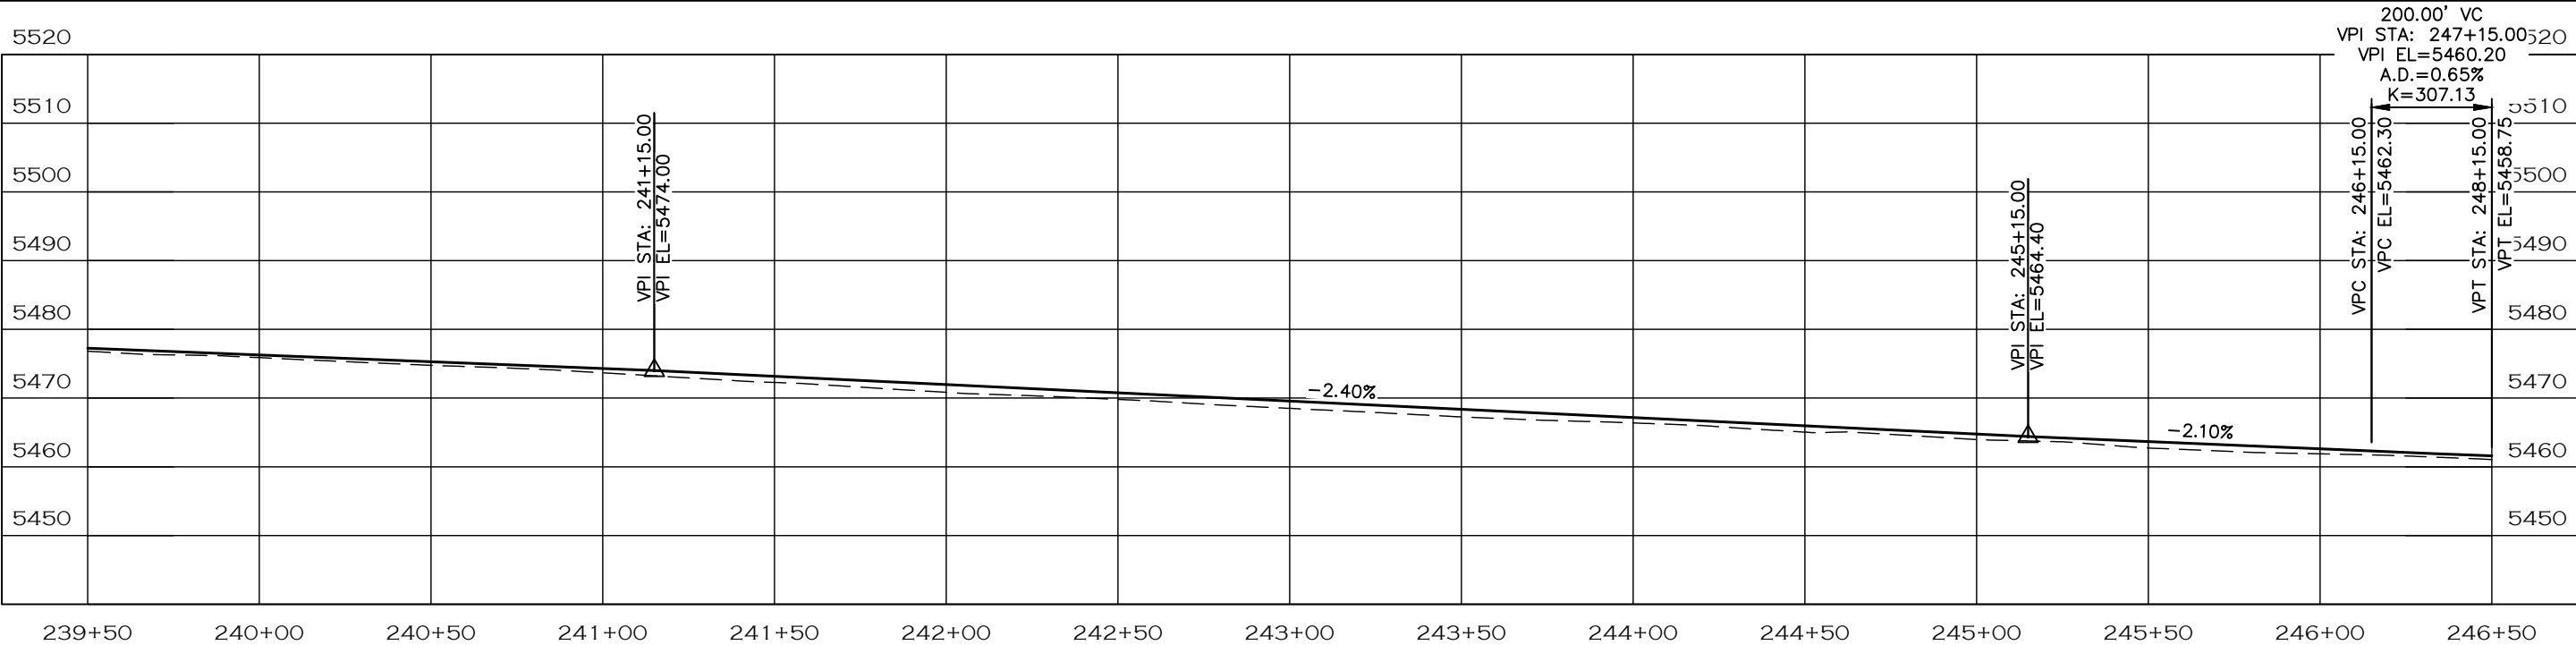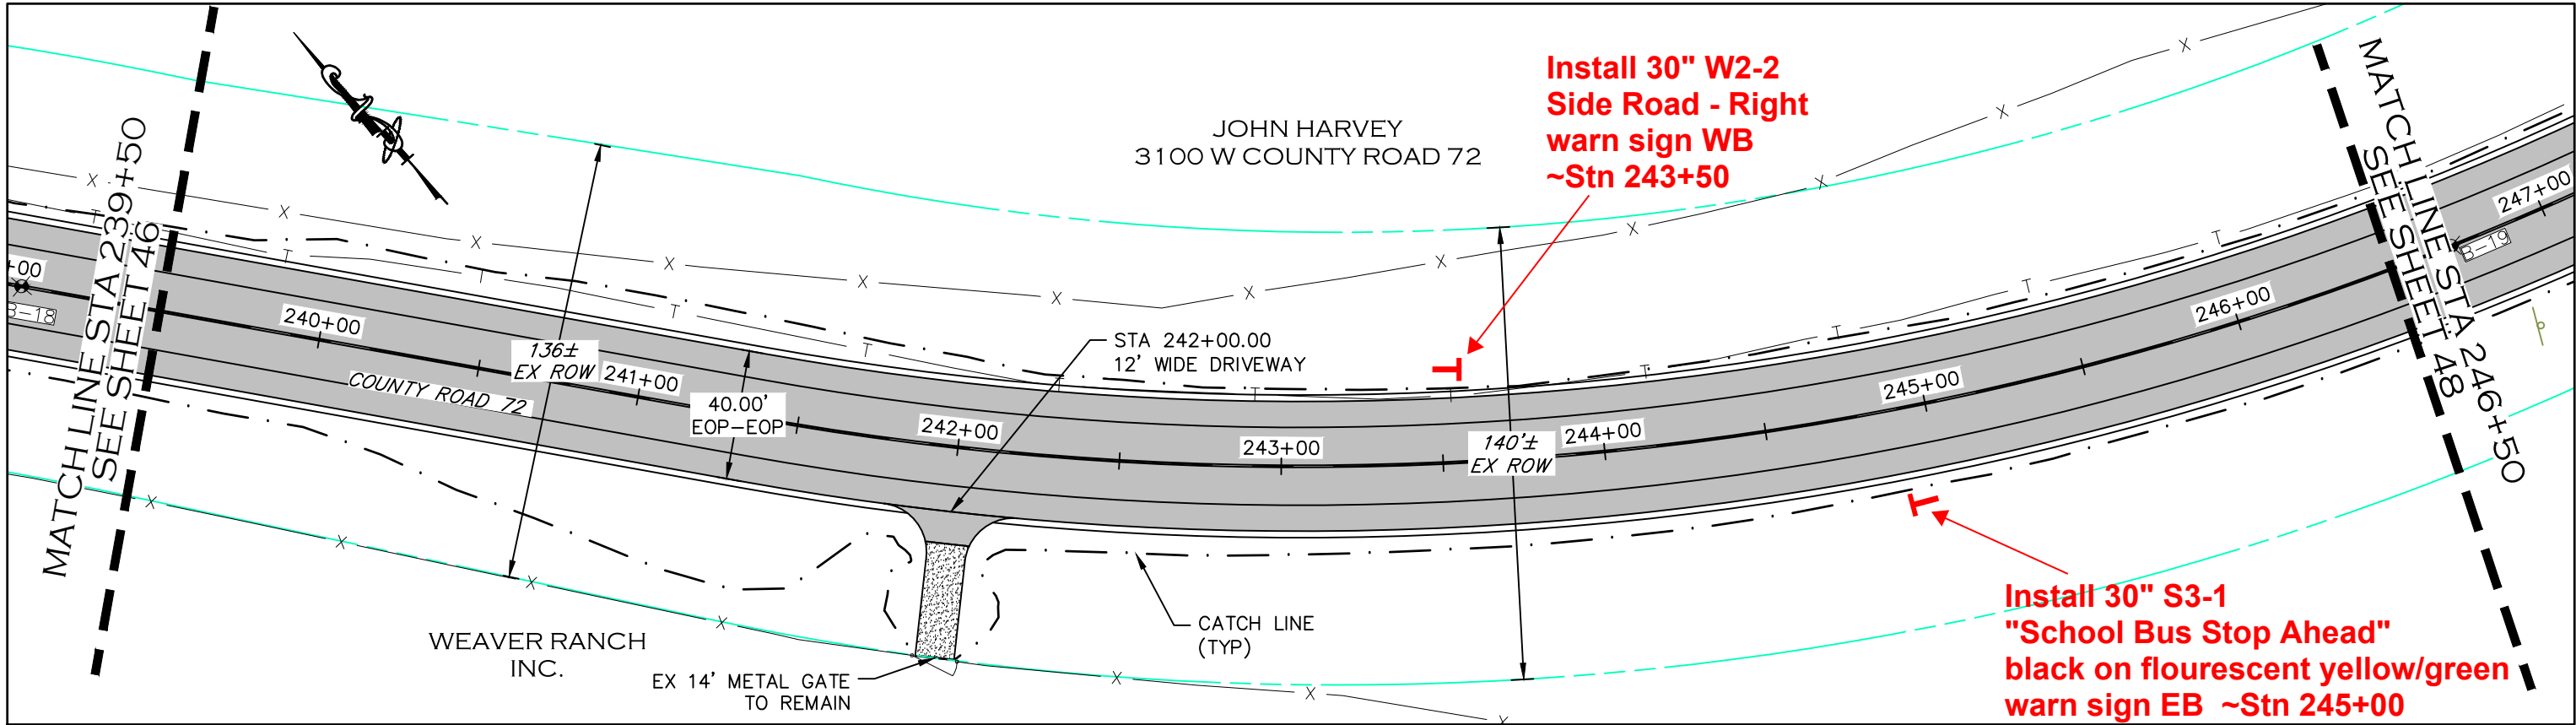




NOTE

1. ALL DRIVEWAY RADII ARE 15 FEET UNLESS OTHERWISE NOTED.
2. PROPOSED FENCE TO BE SET ON PROPOSED ROW. FENCES SHOWN 1' OFF PROPOSED ROW FOR GRAPHICAL PURPOSES.

- PROPOSED FENCE
- TEMPORARY CONSTRUCTION EASEMENT
- PROPOSED RIGHT-OF-WAY
- EXISTING RIGHT-OF-WAY
- EXISTING PROPERTY LINE

CALL UTILITY NOTIFICATION
CENTER OF COLORADO
811
CALL 2-BUSINESS DAYS IN ADVANCE
BEFORE YOU DIG, GRADE, OR EXCAVATE
FOR THE MARKING OF UNDERGROUND
MEMBER UTILITIES.

COMPUTER INFORMATION		REVISIONS			ENGINEERING DEPARTMENT 200 WEST OAK, SUITE 3000 POST OFFICE BOX 1190 FORT COLLINS, COLORADO 80522-1190 (970)498-5700 (970)498-7986 FAX	AS CONSTRUCTED		PLAN & PROFILE STATION 239+50 TO 246+50	PROJECT NO. 335	
CREATION DATE:	07/13/20	R-1				NO REVISIONS:			LARIMER COUNTY ROAD 72	
MODIFICATION DATE:	02/01/21	R-2				REVISED:			SHEET NO. 47	
FILE LOCATION:	INTEREST PROJECTS\2019 PROJECTS\1421-094-00 (LARIMER COUNTY ROAD 72)\DRAWINGS\ENGINEERING PLANS	R-3								
FILE NAME:	1421-094-00 P&P.DWG	R-4								
		R-5								

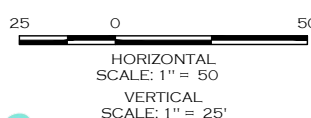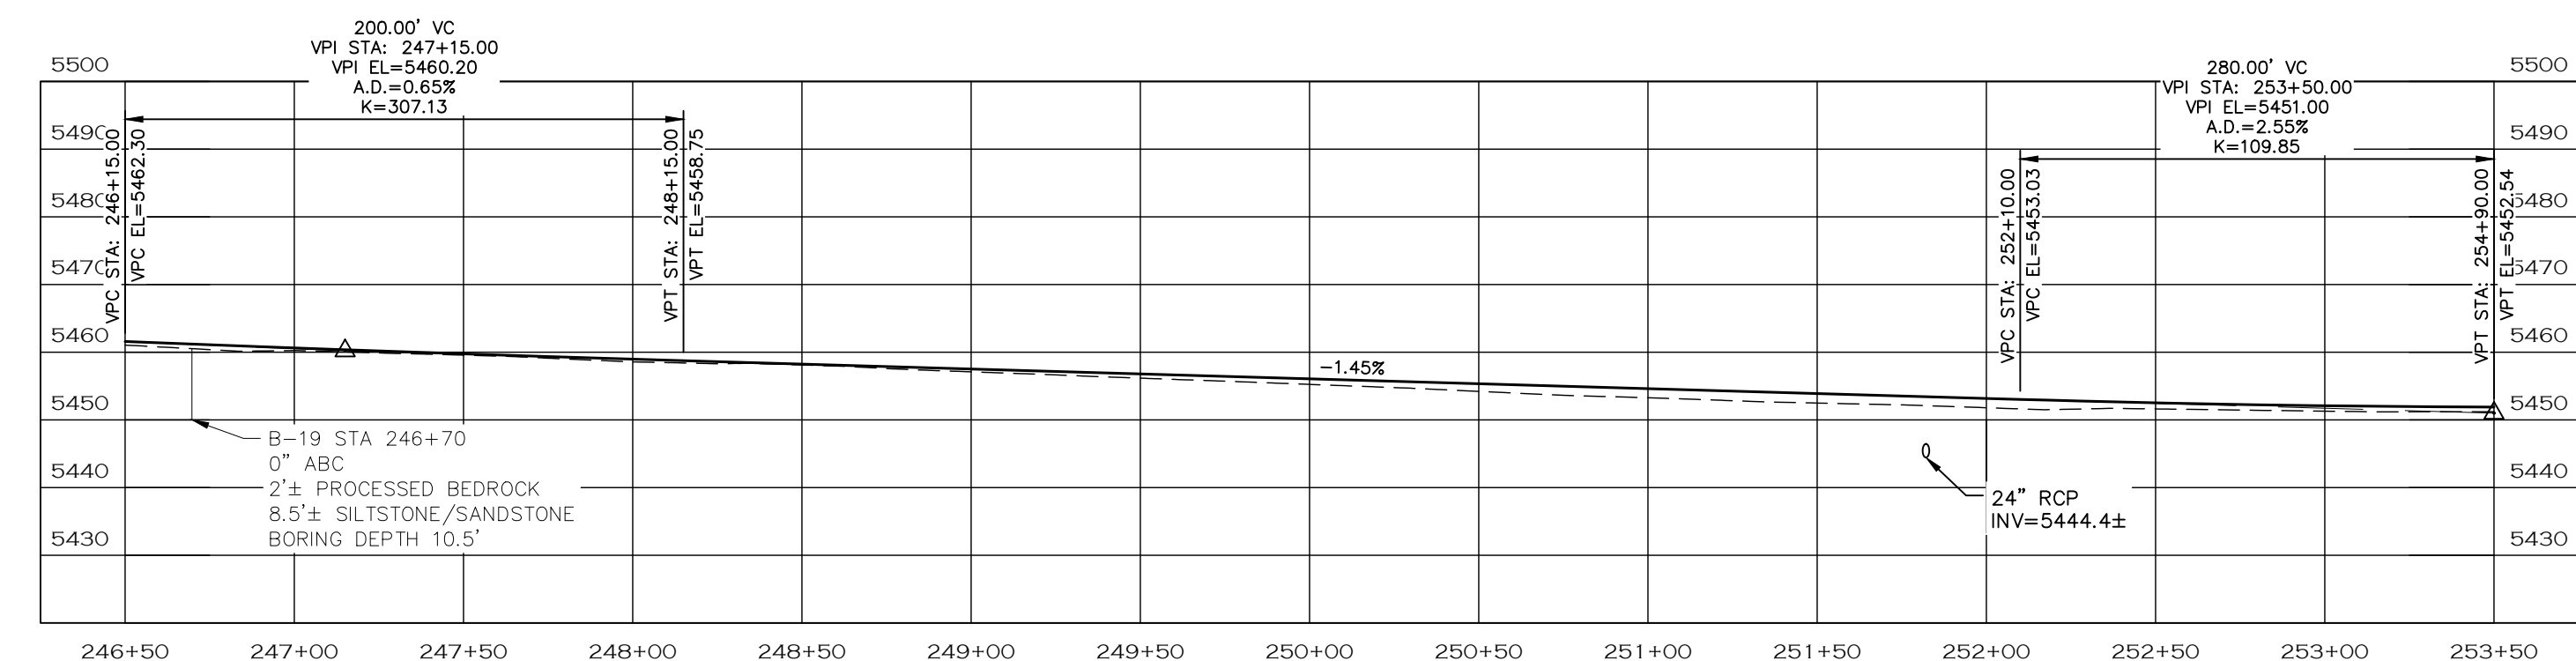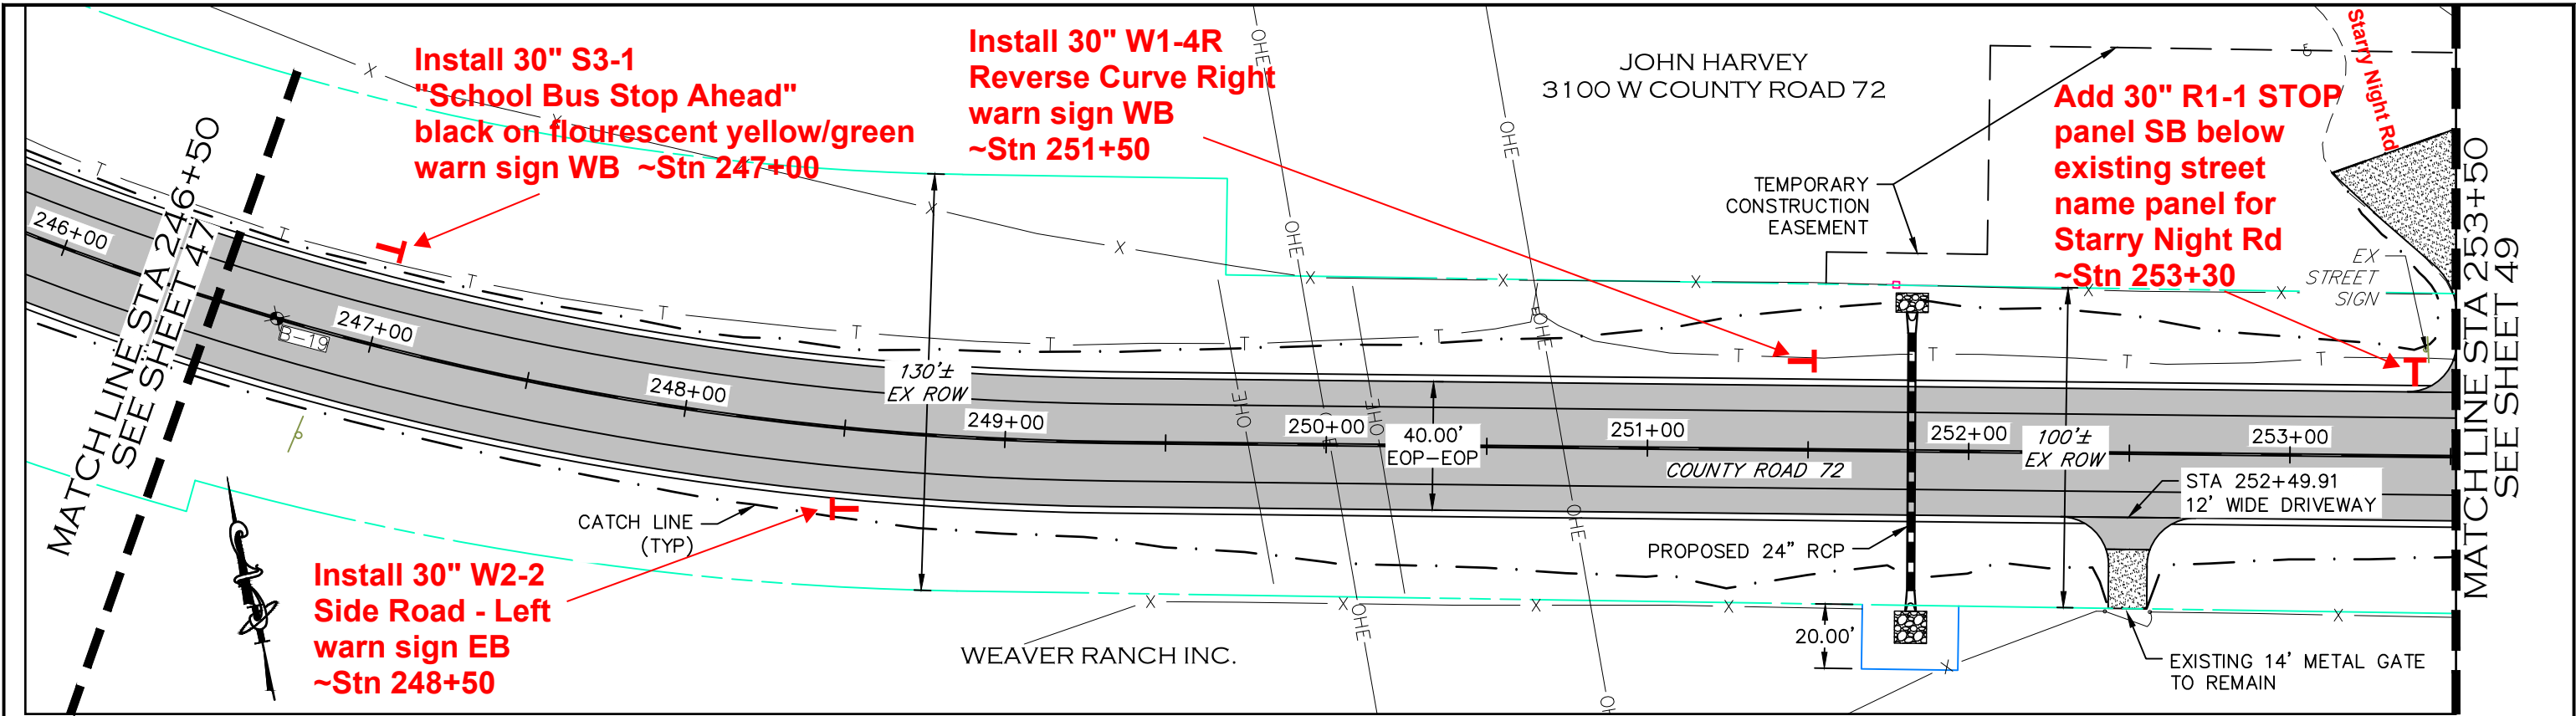



NOTE

1. ALL DRIVEWAY RADII ARE 15 FEET UNLESS OTHERWISE NOTED.
2. PROPOSED FENCE TO BE SET ON PROPOSED ROW. FENCES SHOWN 1' OFF PROPOSED ROW FOR GRAPHICAL PURPOSES.

- PROPOSED FENCE
- TEMPORARY CONSTRUCTION EASEMENT
- PROPOSED RIGHT-OF-WAY
- EXISTING RIGHT-OF-WAY
- EXISTING PROPERTY LINE

CALL UTILITY NOTIFICATION
CENTER OF COLORADO
811
CALL 2-BUSINESS DAYS IN ADVANCE
BEFORE YOU DIG, GRADE, OR EXCAVATE
FOR THE MARKING OF UNDERGROUND
MEMBER UTILITIES.

COMPUTER INFORMATION		REVISIONS			ENGINEERING DEPARTMENT 200 WEST OAK, SUITE 3000 POST OFFICE BOX 1190 FORT COLLINS, COLORADO 80522-1190 (970)498-5700 (970)498-7986 FAX	AS CONSTRUCTED		PLAN & PROFILE STATION 246+50 TO 253+50	PROJECT NO. 335	
CREATION DATE:	07/13/20	☐ R-1				NO REVISIONS:			LARIMER COUNTY ROAD 72	
MODIFICATION DATE:	02/01/21	☐ R-2				REVISED:			SHEET NO. 48	
FILE LOCATION:	INTEREST PROJECTS\2019 PROJECTS\1421-094-00 LARIMER COUNTY ROAD 72\DRAWINGS\ENGINEERING PLANS	☐ R-3				VOID:				
FILE NAME:	1421-094-00 P&P.DWG	☐ R-4								
		☐ R-5								

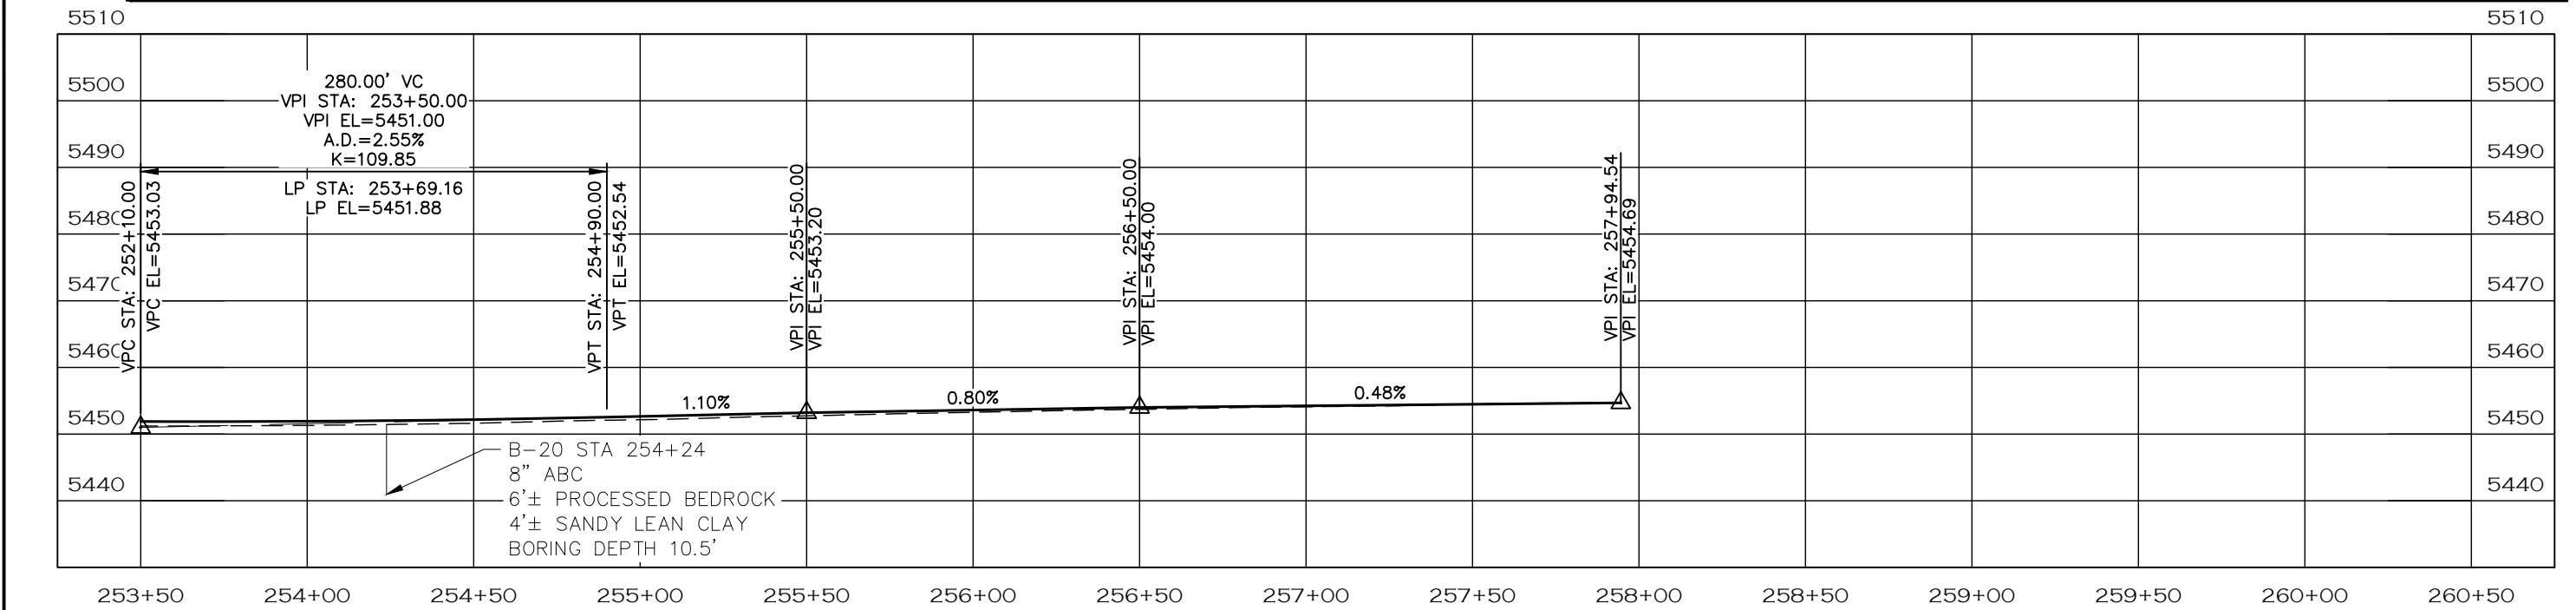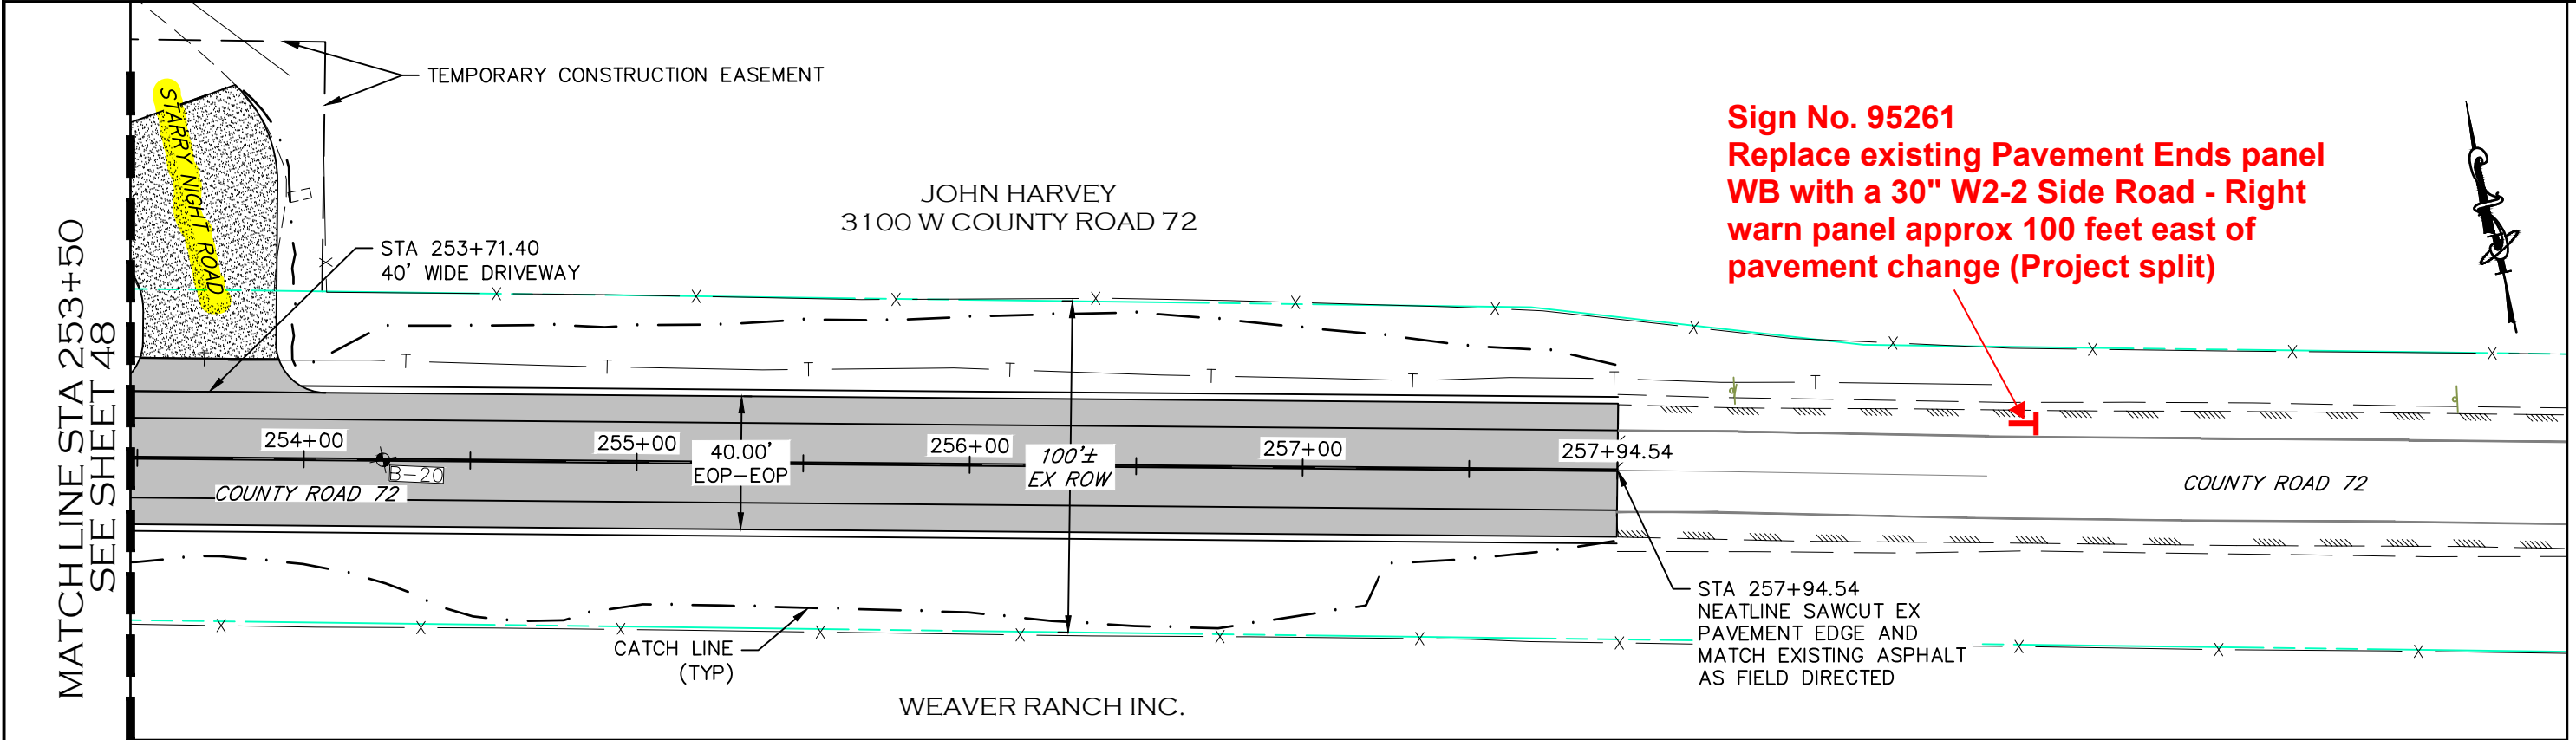

NOTE

1. ALL DRIVEWAY RADII ARE 15 FEET UNLESS OTHERWISE NOTED.
2. PROPOSED FENCE TO BE SET ON PROPOSED ROW. FENCES SHOWN 1' OFF PROPOSED ROW FOR GRAPHICAL PURPOSES.

- PROPOSED FENCE
- TEMPORARY CONSTRUCTION EASEMENT
- PROPOSED RIGHT-OF-WAY
- EXISTING RIGHT-OF-WAY
- EXISTING PROPERTY LINE

CALL UTILITY NOTIFICATION
CENTER OF COLORADO
811
CALL 2-BUSINESS DAYS IN ADVANCE
BEFORE YOU DIG, GRADE, OR EXCAVATE
FOR THE MARKING OF UNDERGROUND
MEMBER UTILITIES.

COMPUTER INFORMATION		REVISIONS			ENGINEERING DEPARTMENT 200 WEST OAK, SUITE 3000 POST OFFICE BOX 1190 FORT COLLINS, COLORADO 80522-1190 (970)498-5700 (970)498-7986 FAX	AS CONSTRUCTED		PLAN & PROFILE STATION 253+50 TO 257+95	PROJECT NO. 335	
CREATION DATE:	07/13/20	R-1				NO REVISIONS:			LARIMER COUNTY ROAD 72	
MODIFICATION DATE:	02/01/21	R-2				REVISED:			SHEET NO. 49	
FILE LOCATION:	INTEREST PROJECTS\2019 PROJECTS\1421-094-00 (LARIMER COUNTY ROAD 72)\DRAWINGS\ENGINEERING PLANS	R-3				VOID:				
FILE NAME:	1421-094-00 P&P.DWG	R-4								
		R-5								

PN 335 - Sign Plan
(pg 51 - Approach to Project
East end. 10/20/2021



Sign No. 95261
Replace existing Pavement Ends panel
WB with a 30" W2-2 Side Road - Right
warn panel approx 100 feet east of
pavement change (Project split)

Remove Sign No. 95251
Speed Limit 40 WB

Install 30" R1-1 STOP
sign NB on private road
(old CR 21)

Replace existing
Truckers Engine Mufflers
sign with R2-1 (50)
30" x 36" Speed Limit 50
sign WB ~ 300 feet east
of WB SBSA sign

Relocate "Truckers - Engine
Brake Mufflers Required"
sign to ~250 in advance of
Speed Limit 50
sign WB

Sign No. 95271
Replace existing W3-5
Speed Limit 35 Ahead symbol
with 30" Black on Yellow/Green
"School Bus Stop Ahead"
sign Westbound